
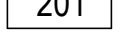

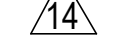



PALM BEACH COUNTY, FLORIDA

www.cheneybrothers.com

ONE CALL DOES IT ALL

[illegible]

GENERAL LEGEND	
	INDICATES EQUIPMENT NUMBER (REFER TO EQUIPMENT SCHEDULE)
	INDICATES ELEVATION DIRECTION
	INDICATES REVISION NUMBER (REFER TO CLOUDED AREAS)
	INDICATES AREA TO REVIEW FOR REVISIONS
	INDICATES SHEET NUMBER

1. THESE DRAWINGS ARE NOT TO BE USED FOR CONSTRUCTION. THESE DRAWING SHOWS GENERAL SPACE AND LAYOUT REQUIREMENTS FOR THE FOOD SERVICE EQUIPMENT. THIS DRAWING IS INTENDED TO COMPLEMENT THE ARCHITECTURAL AND ENGINEERING CONSTRUCTION DOCUMENTS FOR THIS PROJECT AND MUST BE USED AND COORDINATED WITH THOSE DRAWINGS AND SPECIFICATIONS.
2. THESE DRAWINGS ARE INTENDED TO COMPLEMENT THE EQUIPMENT MFR'S CATALOG SHEETS AND SHOP DRAWINGS AND MUST BE USED IN COORDINATION WITH THOSE DRAWINGS AND SPECIFICATIONS.
3. ALL WORK MUST BE PERFORMED AND COMPLY TO ALL PREVAILING HEALTH AND BUILDING CODES. NOTIFY THE PROJECT ARCHITECT IF ANY INFORMATION CONTAINED IN THESE DRAWINGS DOES NOT CONFORM TO ANY CODE ENFORCED.
4. ALL DIMENSIONS SHOWN ARE TO BE MEASURED FROM FINISHED SURFACES AND FROM CENTER LINE OF COLUMNS. ALL WRITTEN DIMENSIONS SUPERSEDE SCALE. DO NOT SCALE DRAWINGS.
5. THE FOOD SERVICE EQUIPMENT WILL BE PROVIDED WITH ONLY THE DEVICES SUPPLIED AS STANDARD BY THE MANUFACTURER SPECIFIED BY THE CONSULTANT. THE GENERAL CONTRACTOR SHALL PROVIDE AND INSTALL ALL OTHER NECESSARY FRAMING, SUPPORTS, BACKING, HARDWARE FINISHES AND ANY OTHER MATERIALS REQUIRED FOR A PROPER INSTALLATION.
6. THE GENERAL CONTRACTOR SHALL VERIFY AND COORDINATE ALL BUILDING ACCESS REQUIREMENTS WITH THE FOOD SERVICE EQUIPMENT CONTRACTOR (FSEC).
7. THE GENERAL CONTRACTOR SHALL COORDINATE ALL FIELD DIMENSIONS AND BUILDING REQUIREMENTS WITH THE FOOD SERVICE EQUIPMENT CONTRACTOR (FSEC).
8. THE GENERAL CONTRACTOR SHALL VERIFY ALL REQUIREMENTS FOR ITEMS LISTED AS: EXISTING, BY OWNER, BY VENDOR, OR BY OTHERS.

THIS DRAWING IS AN INSTRUMENT OF SERVICE ONLY FOR THE LICENSED ARCHITECT
AND/OR ENGINEER ON THIS PROJECT.

PURSUANT TO FLORIDA STATUTE 481.229 SECTIONS 8A, 8B, AND 8C THESE DESIGNS, SPECIFICATIONS AND/OR LAYOUT
CANNOT BE USED FOR CONSTRUCTION AND/OR INSTALLATION OF EQUIPMENT UNLESS REVIEWED AND APPROVED BY
LICENSED ARCHITECT OR ENGINEER.

THESE DRAWINGS ARE PRELIMINARY AND CONCEPTUAL IN NATURE THEY ARE PROVIDED FOR GENERAL INFORMATION
PURPOSES ONLY. ANYONE MAKING USE OF THESE DRAWINGS DOES SO AT THEIR OWN RISK AND ASSUMES ALL LIABILITY
FOR SUBSEQUENT USE.

Cheney



Brothers

EQUIPMENT & DESIGN DIVISION

2061 Martin Luther King Jr. Blvd.
Riviera Beach, Florida, 33404

1-877-CB-CHEE (224-2433)

www.cheneybrothers.com

THIS DRAWING, INTELLECTUAL PROPERTY, AND ALL ATTACHMENTS HERETO, ARE THE SOLE PROPERTY OF CHENEY BROTHERS, INC. THE RECIPIENT OF THIS DRAWING IS HEREBY NOTIFIED THAT ANY REPRODUCTION, COPIING, OR DISSEMINATION OF THIS DRAWING, OR ANY PARTS THEREOF, WITHOUT THE WRITTEN CONSENT OF CHENEY BROTHERS, INC. IS STRICTLY PROHIBITED. NEITHER THIS DRAWING NOR ANY PARTS THEREOF ARE TO BE LOANED, REPRODUCED, COPIED, OR DISSEMINATED TO ANY PERSON NOT AVOIDED WRITTEN CONSENT FROM CHENEY BROTHERS, INC. FURTHERMORE, ANY DISSEMINATION IN WHOLE OR IN PART OF THIS DRAWING OR ANY PARTS THEREOF TO ANY OTHER PARTY WITHOUT DAMAGES OR FOR ANY PURPOSE OR CAUSING ANY MATERIAL EXCEEDS IS INTENDED TO BE USED AS INSTRUMENTS OF SERVICE PREPARED FOR THE EXCLUSIVE USE OF CHENEY BROTHERS, INC. CHENEY BROTHERS, INC. ASSUMES NO RESPONSIBILITY FOR ANY CHANGES REQUIRED BY ANY BUILDING CODES OR LOCAL ORDINANCES ETC. AND THEREFORE MUST BE USED WITH ALL LOCAL AGENCIES SAIDED FOR THIS PURPOSE MUST BE

DESIGN APPROVAL


☐ APPROVED ☐ APPROVED AS NOTED ☐ RESUBMIT W/ NEW DESIGN

APPROVED BY: _____

TITLE _____ DATE _____

REVISIONS AND MODIFICATIONS:		
NO.	DESCRIPTION	DATE
Δ	DESIGN ADJUSTMENTS	09/14/72
Δ	DESIGN ADJUSTMENTS; MEP & ELEVATIONS RELEASE	10/17/72
Δ	ADJUSTMENTS PER NEW ARCHITECTURAL BASE;	10/19/72
Δ	ADDED ITEM 710.1	
Δ	GENERAL REVISIONS; REVISED COOKING SUITE ITEM 700	11/23/72

COV.

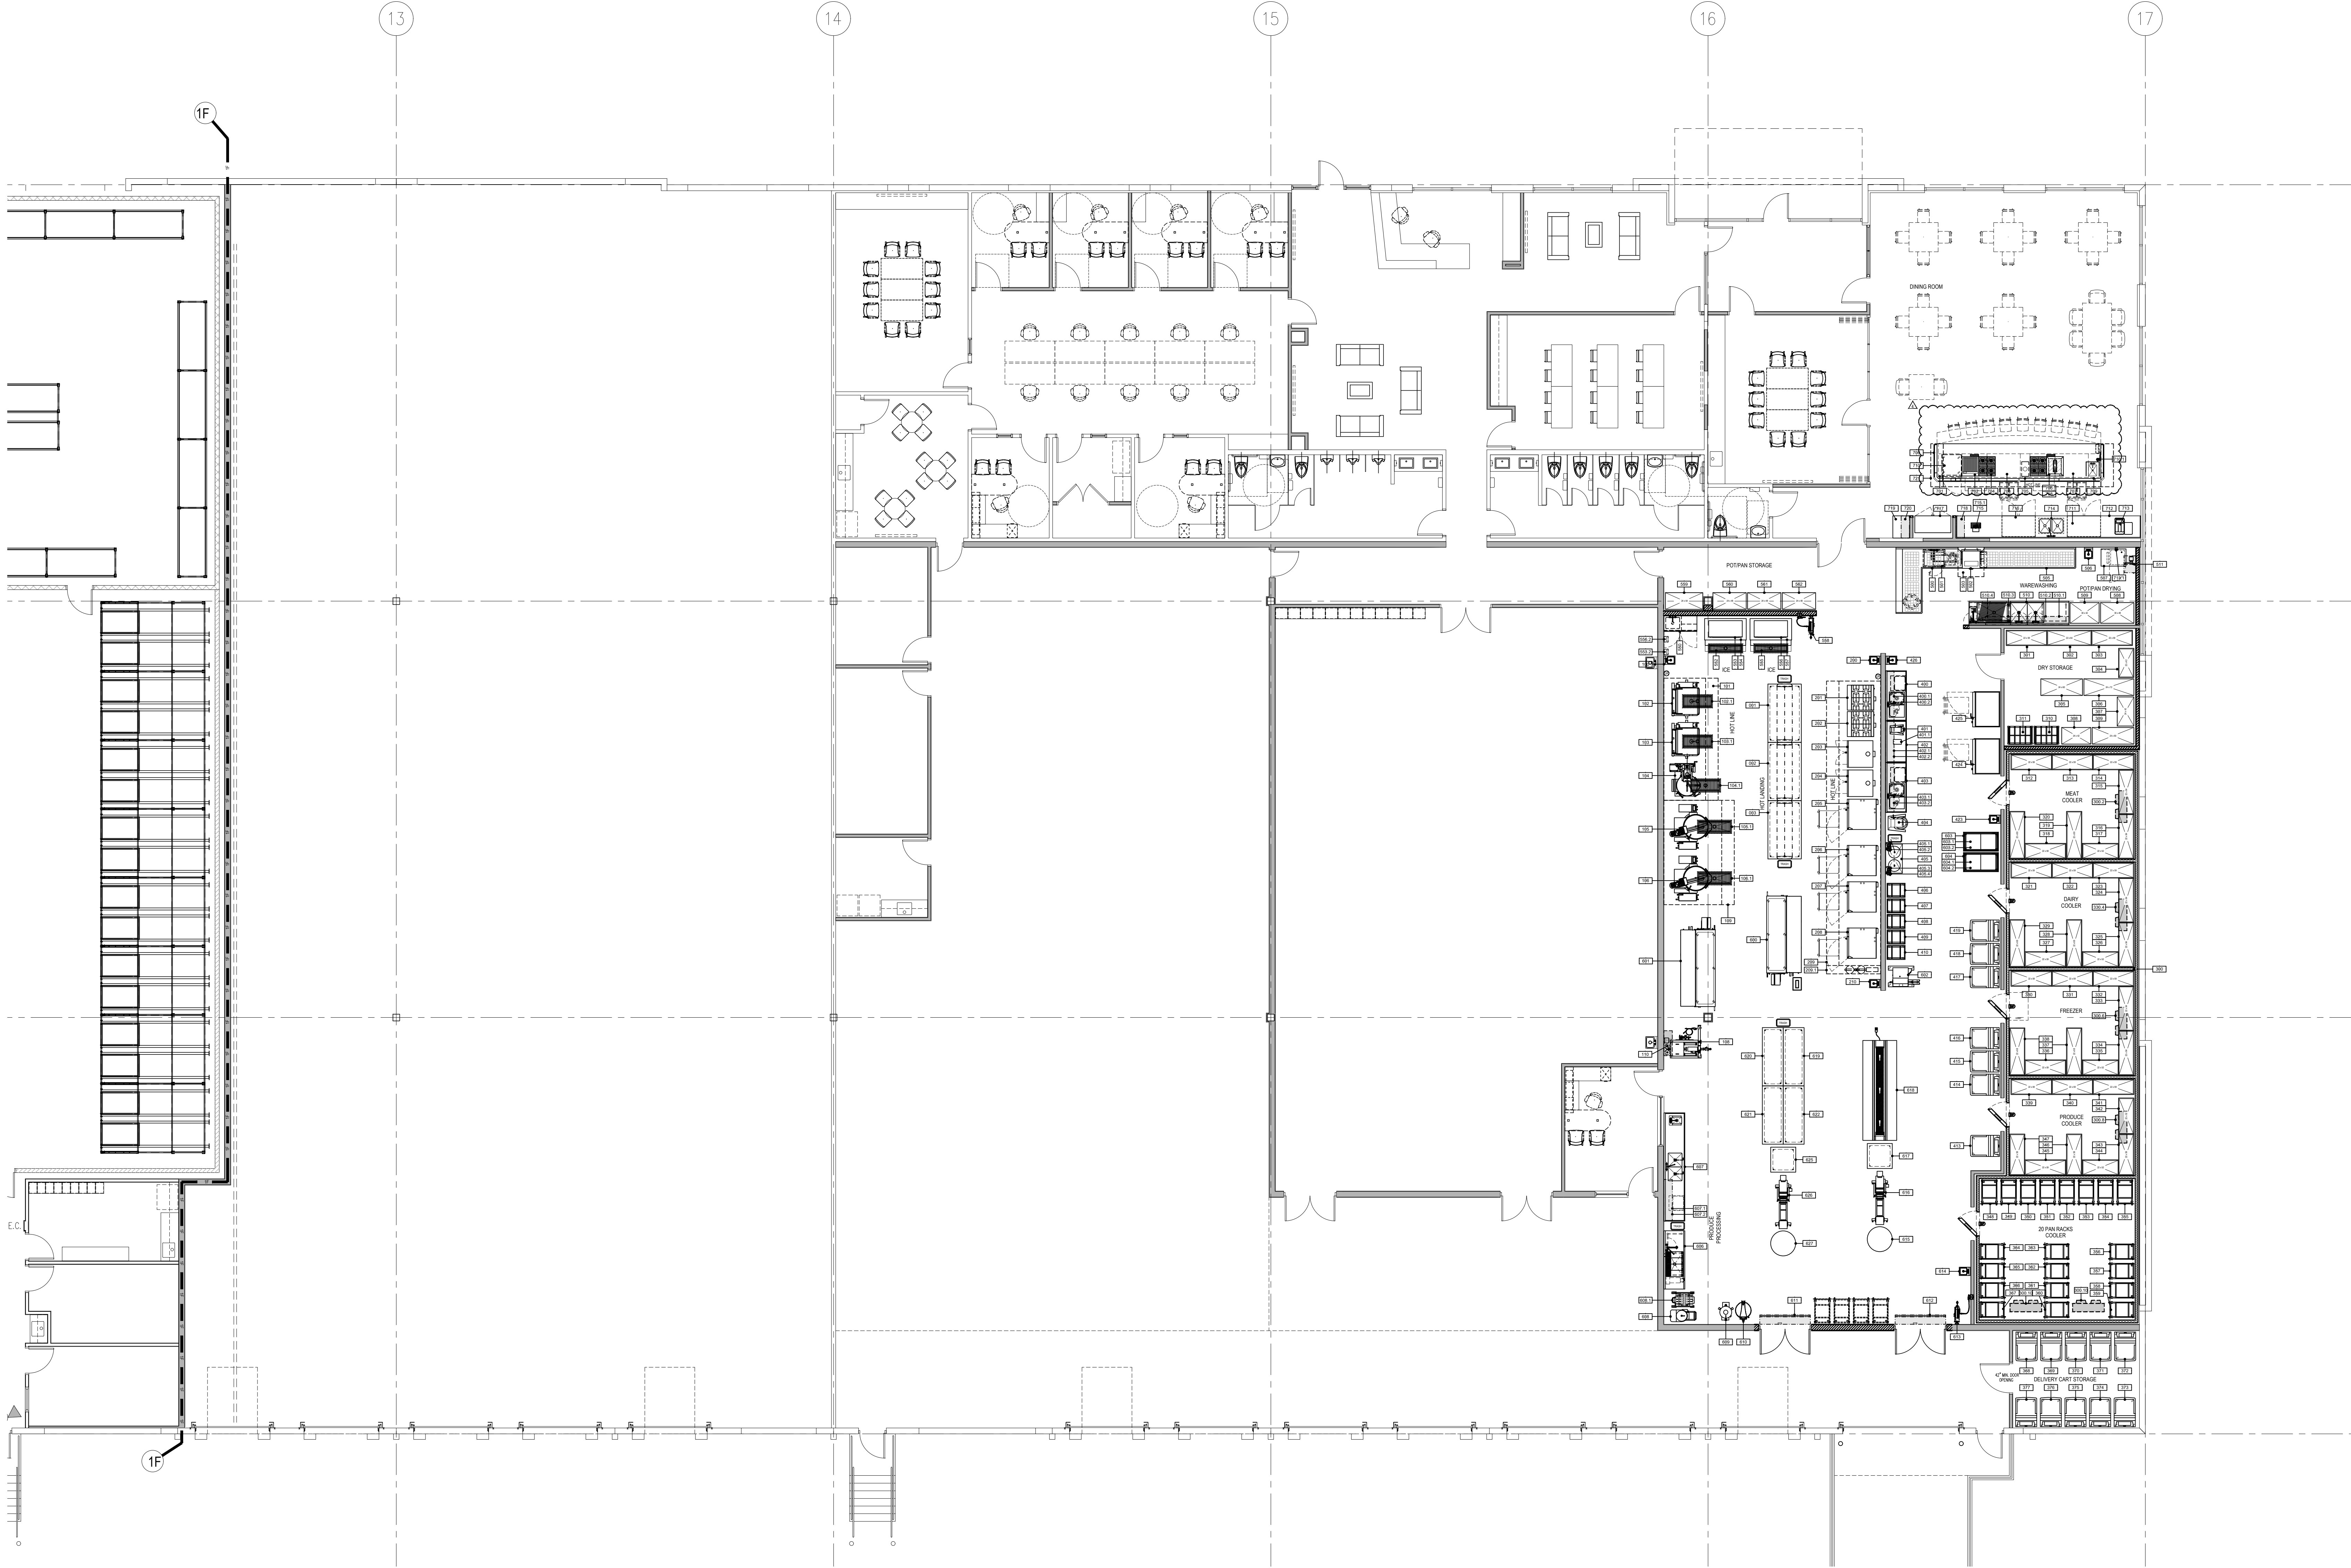

- NOT FOR CONSTRUCTION -

THIS DRAWING IS AN INSTRUMENT OF SERVICE ONLY FOR THE LICENSED ARCHITECT AND/OR ENGINEER ON THIS PROJECT.

PURSUANT TO FLORIDA STATUTE 481.229 SECTIONS 8A, 8B AND 8C THESE DESIGNS, SPECIFICATIONS AND/OR LAYOUTS CANNOT BE USED FOR CONSTRUCTION AND/OR INSTALLATION OF EQUIPMENT UNLESS REVIEWED AND APPROVED BY A LICENSED ARCHITECT OR ENGINEER.

THESE DRAWINGS ARE PRELIMINARY AND CONCEPTUAL IN NATURE. THEY ARE PROVIDED FOR GENERAL INFORMATION PURPOSES ONLY. ANYONE MAKING USE OF THESE DRAWINGS DOES SO AT THEIR OWN RISK AND ASSUMES ALL LIABILITY FOR SUBSEQUENT USE.

FOODSERVICE OVERALL EQUIPMENT PLAN

DESIGN DEVELOPMENT
KITCHEN DESIGN
CBI-22158
PALM BEACH COUNTY, FLORIDA

Cheney Brothers
EQUIPMENT & DESIGN DIVISION
3500 S. US HWY 1, SUITE 300
PALM BEACH, FLORIDA 33480
TEL: 561-837-0844
WWW.CHENEYBROTHERS.COM



DATE: 08-06-2022
DRAWN: SC / JV
CHECKED: JC
JOB No.: CBI-22158
SHEET: K1-1.0

THIS DRAWING, INCLUDING ALL ATTACHMENTS, IS THE PROPERTY OF CHENEY BROTHERS, INC. AND IS NOT TO BE REPRODUCED, COPIED, OR USED IN ANY MANNER WITHOUT THE WRITTEN PERMISSION OF CHENEY BROTHERS, INC. ANY INFORMATION CONTAINED HEREIN IS UNCLASSIFIED AND IS NOT TO BE RELEASED TO THE PUBLIC OR ANY OTHER PARTY WITHOUT THE WRITTEN PERMISSION OF CHENEY BROTHERS, INC. ANY INFORMATION CONTAINED HEREIN IS UNCLASSIFIED AND IS NOT TO BE RELEASED TO THE PUBLIC OR ANY OTHER PARTY WITHOUT THE WRITTEN PERMISSION OF CHENEY BROTHERS, INC. ANY INFORMATION CONTAINED HEREIN IS UNCLASSIFIED AND IS NOT TO BE RELEASED TO THE PUBLIC OR ANY OTHER PARTY WITHOUT THE WRITTEN PERMISSION OF CHENEY BROTHERS, INC.

DESIGN APPROVAL
☐ APPROVED ☐ APPROVED AS NOTED ☐ RESUBMIT WITH REVISIONS
APPROVED BY: _____ DATE: _____
TITLE: _____

NO.	DESCRIPTION	DATE
1	DESIGN APPROVAL	08/06/2022
2	DESIGN APPROVAL	08/06/2022
3	DESIGN APPROVAL	08/06/2022
SCALE: 1/8"=1'-0"

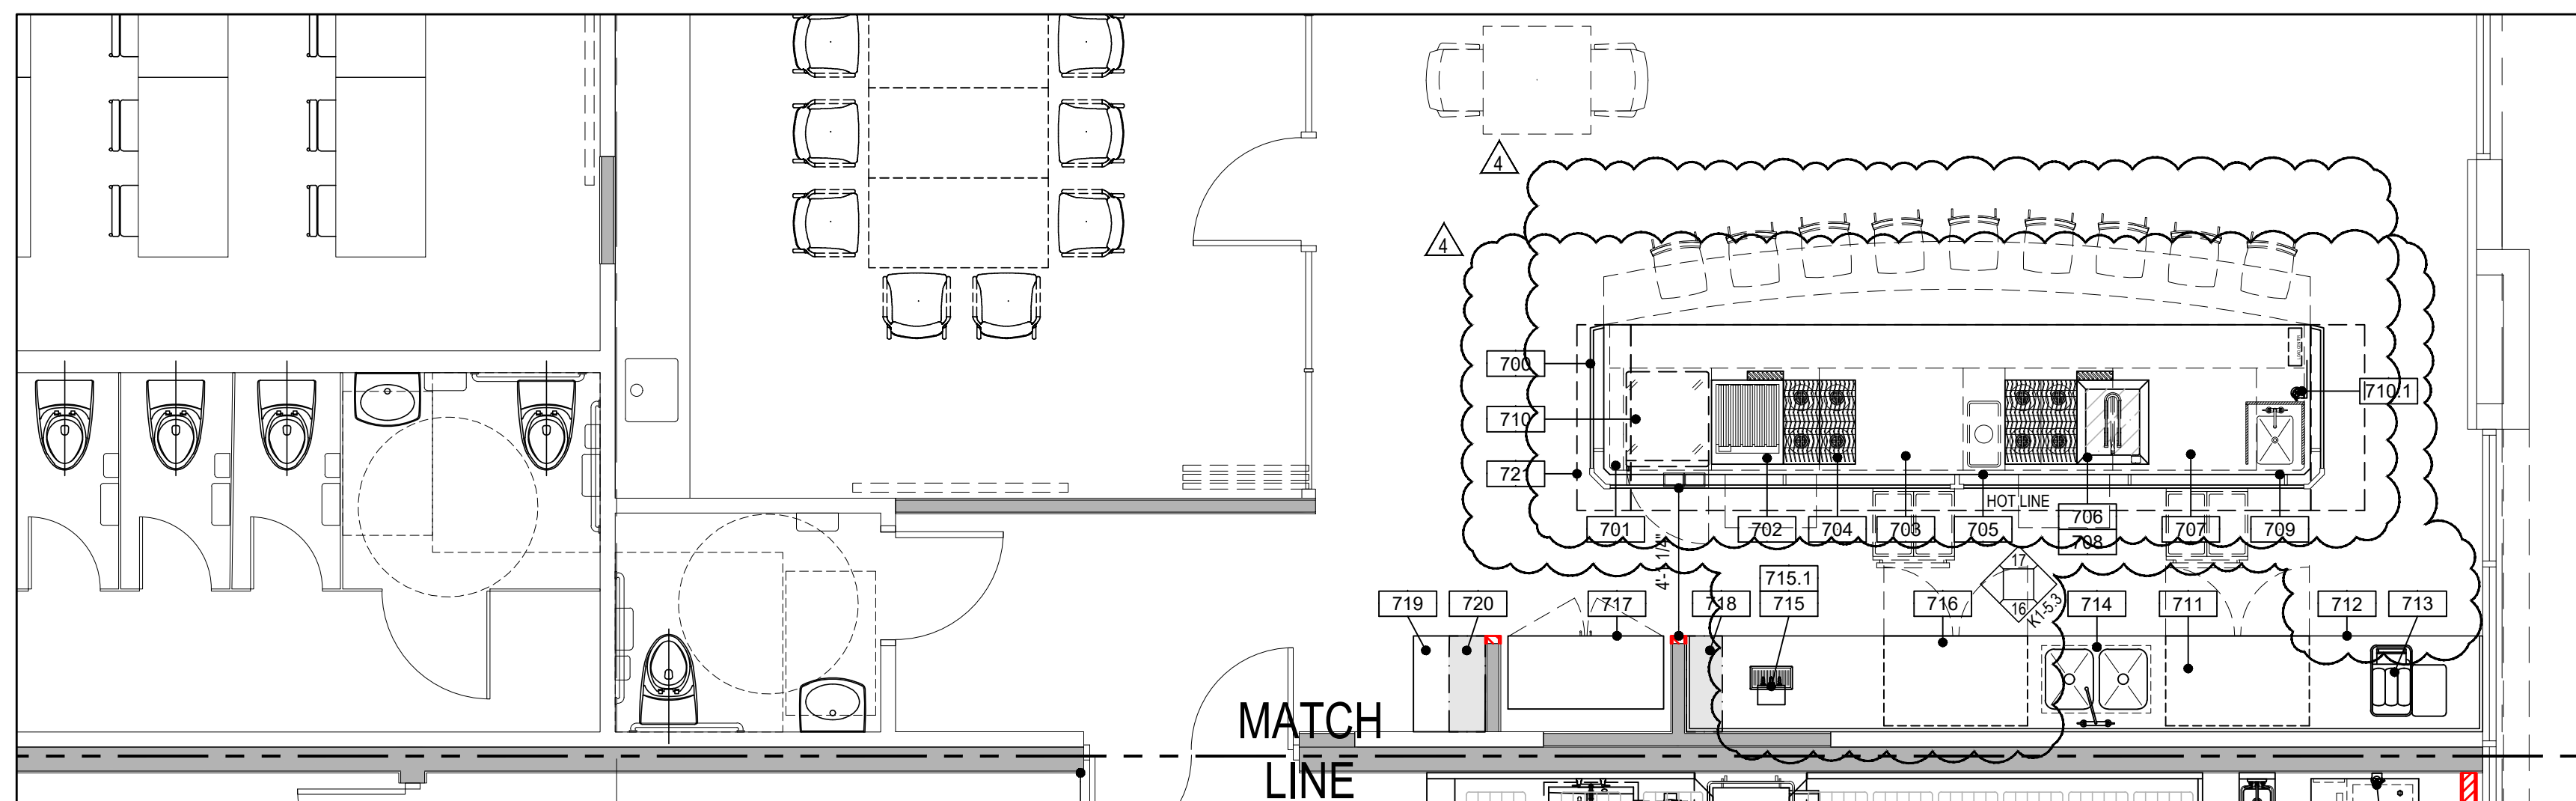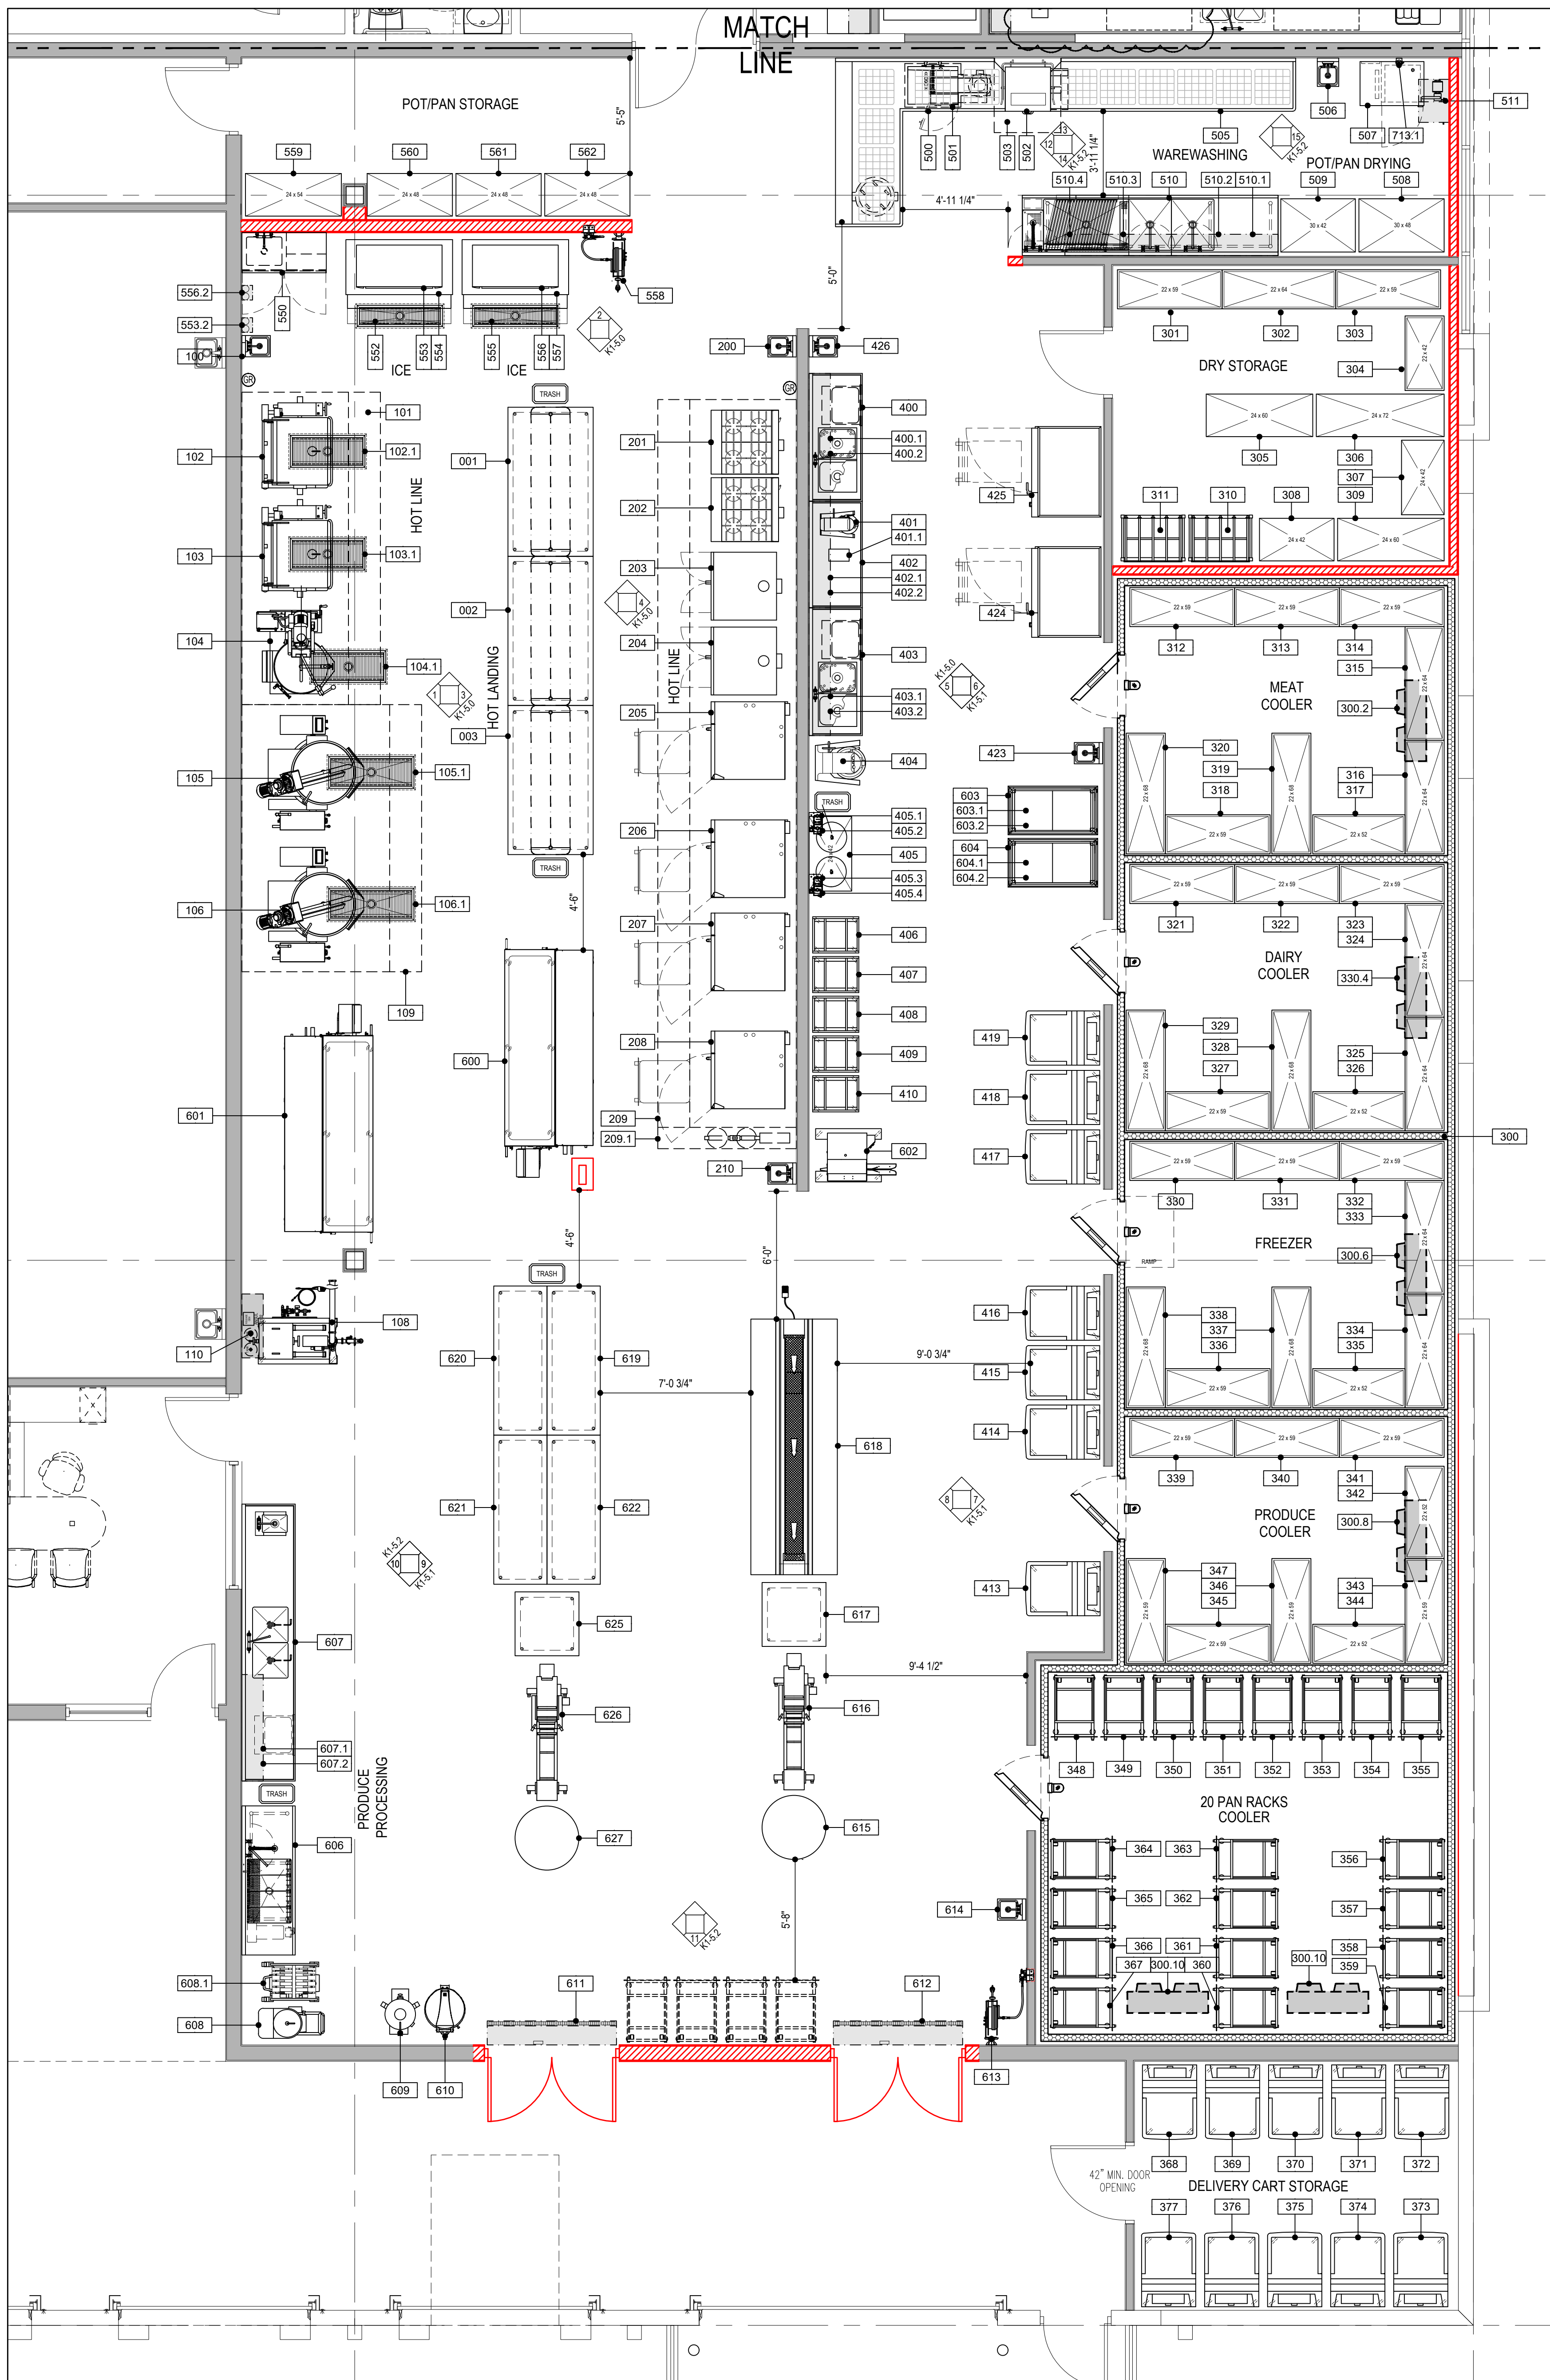

EQUIPMENT SCHEDULE			
REVISION	ITEM NO.	QTY	EQUIPMENT CATEGORY
001	1	1	WORKTABLE, STAINLESS STEEL TOP
002	1	1	WORKTABLE, STAINLESS STEEL TOP
003	1	1	WORKTABLE, STAINLESS STEEL TOP
100	1	1	HAND SINK, WALL MOUNT
101	1	1	EXHAUST HOOD
102	1	1	TILT SKILLET, GAS
103	1	1	TILT SKILLET, GAS
103.1	1	1	FLOOR TROUGH
104	1	1	INCLINED AGITATOR KETTLE, GAS
104.1	1	1	FLOOR TROUGH
105	1	1	COOKCHILL, KETTLE W/ AGITATOR
105.1	1	1	FLOOR TROUGH
106	1	1	COOKCHILL, KETTLE W/ AGITATOR
106.1	1	1	FLOOR TROUGH
107	1	1	COOKCHILL, AIR COMPRESSOR
107.1	1	1	COOKCHILL, REFRIGERATED AIR DRYER
108	1	1	COOKCHILL, LOW TO MID VOLUME PUMP
109	1	1	EXHAUST HOOD
110	1	1	FIRE SUPPRESSION SYSTEM CABINET
200	1	1	HAND SINK, WALL MOUNT
201	1	1	HD RANGE, 36" 4 OPEN BURNERS
202	1	1	HD RANGE, 36" 4 OPEN BURNERS
203	1	1	OVEN, CONVECTION, GAS
204	1	1	OVEN, CONVECTION, GAS
205	1	1	COMBI OVEN, GAS
206	1	1	COMBI OVEN, GAS
207	1	1	COMBI OVEN, GAS
208	1	1	COMBI OVEN, GAS
209	1	1	EXHAUST HOOD
209.1	1	1	FIRE SUPPRESSION SYSTEM
210	1	1	HAND SINK, WALL MOUNT
300	1	1	WALK-IN COOLERS/FREEZER UNIT (5-COMPARTMENTS)
300.1	1	1	MEAT COOLER CONDENSING UNIT
300.2	1	1	MEAT COOLER EVAPORATOR
300.3	1	1	DAIRY COOLER CONDENSING UNIT
300.4	1	1	DAIRY COOLER EVAPORATOR
300.5	1	1	FREEZER CONDENSING UNIT
300.6	1	1	FREEZER EVAPORATOR
300.7	1	1	PRODUCE COOLER CONDENSING UNIT
300.8	1	1	PRODUCE COOLER EVAPORATOR
300.9	1	1	20-PAN RACK COOLER CONDENSING UNIT
300.10	1	1	20-PAN RACK COOLER EVAPORATOR
301	1	1	SHELVING UNIT
302	1	1	SHELVING UNIT
303	1	1	SHELVING UNIT
304	1	1	SHELVING UNIT
305	1	1	SHELVING UNIT
306	1	1	SHELVING UNIT
307	1	1	SHELVING UNIT
308	1	1	SHELVING UNIT
309	1	1	SHELVING UNIT
310	1	1	RACK, CAN
311	1	1	RACK, CAN
312	1	1	SHELVING UNIT
313	1	1	SHELVING UNIT
620	1</		

EQUIPMENT SCHEDULE																											
REVISION	ITEM NO	QTY	EQUIPMENT CATEGORY	EQUIPMENT REMARKS	VOLTS	CYCLE	PHASE	DIRECT	CORD/PLUG	NEMA	AMPS	KW	HP	ELECTRICAL AFF (IN)	ELECTRICAL REMARKS	GAS MBTU/H	GAS SIZE (IN)	GAS (IN)	COLD WATER SIZE (IN)	COLD WATER AFF (IN)	HOT WATER SIZE (IN)	HOT WATER AFF (IN)	DIRECT DRAIN SIZE (IN)	INDIRECT DRAIN SIZE (IN)	COMPRESSED AIR SIZE (IN)	COMPRESSED AIR AFF (IN)	PLUMBING REMARKS
	001	1	WORKTABLE, STAINLESS STEEL TOP	W/ SCT-84 POT RACK																							
	002	1	WORKTABLE, STAINLESS STEEL TOP	W/ SCT-84 POT RACK																							
	003	1	WORKTABLE, STAINLESS STEEL TOP	W/ SCT-84 POT RACK																							
	100	1	HAND SINK, WALL MOUNT																1/2	14	1/2	14	1-1/2				
	101	1	EXHAUST HOOD	REFER TO SHOP DRAWINGS WHEN AVAILABLE											VERIFY UTILITIES W/SHOP DRAWINGS WHEN AVAILABLE												
	102	1	TILT SKILLET, GAS		115	60	1	X			5.0			18		144	1/2	24	1/2	14							W/ SINGLE PANTRY FAUCET
	102.1	1	FLOOR TROUGH																			4					
	103	1	TILT SKILLET, GAS		115	60	1	X			5.0			18		144	1/2	24	1/2	14							W/ SINGLE PANTRY FAUCET
	103.1	1	FLOOR TROUGH																			4					
	104	1	INCLINED AGITATOR KETTLE, GAS		115	60	1	X			5			18	KETTLE	150	1/2	24	1/2	14	1/2	14			1/2	14	W/ DOUBLE PANTRY FAUCET
	104.1	1	FLOOR TROUGH		208	60	3	X			6.8		2.0	18	AGITATOR								4				
	105	1	COOK/CHILL, KETTLE W/ AGITATOR		208	60	3	X			11.0			18	20 AMPS SERVICE	300	1	24	3/4	14				1/2	14		
	105.1	1	FLOOR TROUGH																			4					
	106	1	COOK/CHILL, KETTLE W/ AGITATOR		208	60	3	X			11.0			18	20 AMPS SERVICE	300	1	24	3/4	14				1/2	14		
	106.1	1	FLOOR TROUGH																			4					
	107	1	COOK/CHILL, AIR COMPRESSOR	LOCATION TO BE DETERMINED	208	60	1	X			23.0			18													
	107.1	1	COOK/CHILL, REFRIGERATED AIR DRYER	LOCATION TO BE DETERMINED	115	60	1		X	5-15P	--			18													
	108	1	COOK/CHILL, LOW TO MID VOLUME PUMP																								
	109	1	EXHAUST HOOD	REFER TO SHOP DRAWINGS WHEN AVAILABLE											VERIFY UTILITIES W/SHOP DRAWINGS WHEN AVAILABLE									1/2	14	*	SEE NOTE IN PLUMBING PLAN FOR ADDITIONAL HEIGHT
	110	1	FIRE SUPPRESSION SYSTEM CABINET	REFER TO SHOP DRAWINGS WHEN AVAILABLE											VERIFY UTILITIES W/SHOP DRAWINGS WHEN AVAILABLE												
	200	1	HAND SINK, WALL MOUNT																1/2	14	1/2	14	1-1/2				
	201	1	HD RANGE, 36", 4 OPEN BURNERS		115	60	1		X	5-15P	4.0			18		170	3/4	24									
	202	1	HD RANGE, 36", 4 OPEN BURNERS		115	60	1		X	5-15P	4.0			18		170	3/4	24									
	203	1	OVEN, CONVECTION, GAS		120	60	1		X	5-15P	6.0		1/2	18		50	3/4	24									
					120	60	1		X	5-15P	6.0		1/2	48		50	3/4	48									
	204	1	OVEN, CONVECTION, GAS		120	60	1		X	5-15P	6.0		1/2	18		50	3/4	24									
					120	60	1		X	5-15P	6.0		1/2	48		50	3/4	48									
	205	1	COMBI OVEN, GAS		120	60	1	X			13.6	1.7		18	REQUIRES 20 AMPS BREAKER	266	3/4	24	3/4				1-1/2				FILTERED COLD WATER FROM ITEM 405.1
	206	1	COMBI OVEN, GAS		120	60	1	X			13.6	1.7		18	REQUIRES 20 AMPS BREAKER	266	3/4	24	3/4				1-1/2				FILTERED COLD WATER FROM ITEM 405.2
	207	1	COMBI OVEN, GAS		120	60	1	X			13.6	1.7		18	REQUIRES 20 AMPS BREAKER	266	3/4	24	3/4				1-1/2				FILTERED COLD WATER FROM ITEM 405.3
	208	1	COMBI OVEN, GAS		120	60	1	X			13.6	1.7		18	REQUIRES 20 AMPS BREAKER	266	3/4	24	3/4				1-1/2				FILTERED COLD WATER FROM ITEM 405.4
	209	1	EXHAUST HOOD	REFER TO SHOP DRAWINGS WHEN AVAILABLE											VERIFY UTILITIES W/SHOP DRAWINGS WHEN AVAILABLE												
	209.1	1	FIRE SUPPRESSION SYSTEM	REFER TO SHOP DRAWINGS WHEN AVAILABLE											VERIFY UTILITIES W/SHOP DRAWINGS WHEN AVAILABLE												
	210	1	HAND SINK, WALL MOUNT																1/2	14	1/2	14	1-1/2				
	300	1	WALK-IN COOLERS/FREEZER UNIT (5-COMPARTMENTS)		(5)120	60	1	X			(5)15.0			114	VERIFY WITH SHOP DRAWINGS												
					(3)120	60	1	X			(3)15.0			18	ELECTRICAL SERVICE FOR DRAIN PUMP IF NEEDED												
	300.1	1	MEAT COOLER CONDENSING UNIT		208-230	60	1	X			10.8		1-1/2	TBD	VERIFY WITH SHOP DRAWINGS												
	300.2	1	MEAT COOLER EVAPORATOR		115	60	1	X			1.6			114	VERIFY WITH SHOP DRAWINGS								3/4				VERIFY WITH SHOP DRAWINGS
	300.3	1	DAIRY COOLER CONDENSING UNIT		208-230	60	1	X			10.8		1-1/2	TBD	VERIFY WITH SHOP DRAWINGS												
	300.4	1	DAIRY COOLER EVAPORATOR		115	60	1	X			1.6			114	VERIFY WITH SHOP DRAWINGS								3/4				VERIFY WITH SHOP DRAWINGS
	300.5	1	FREEZER CONDENSING UNIT		208-230	60	1	X			22.4		4	TBD	VERIFY WITH SHOP DRAWINGS												
	300.6	1	FREEZER EVAPORATOR		208-230	60	1	X			14.3			114	VERIFY WITH SHOP DRAWINGS								3/4				VERIFY WITH SHOP DRAWINGS
	300.7	1	PRODUCE COOLER CONDENSING UNIT		208-230	60	1	X			11.3		1-1/4	TBD	VERIFY WITH SHOP DRAWINGS												
	300.8	1	PRODUCE COOLER EVAPORATOR		115	60	1	X			1.6			114	VERIFY WITH SHOP DRAWINGS								3/4				VERIFY WITH SHOP DRAWINGS
	300.9	1	20-PAN RACK COOLER CONDENSING UNIT		208-230	60	1	X			16.2		2-1/2	TBD	VERIFY WITH SHOP DRAWINGS												
	300.10	2	20-PAN RACK COOLER EVAPORATOR		115	60	1	X			1.6			114	VERIFY WITH SHOP DRAWINGS								3/4				VERIFY WITH SHOP DRAWINGS
	301	1	SHELVING UNIT																								
	302	1	SHELVING UNIT																								
	303	1	SHELVING UNIT																								
	304	1	SHELVING UNIT																								
	305	1	SHELVING UNIT																								
	306	1	SHELVING UNIT																								
	307	1	SHELVING UNIT																								
	308	1	SHELVING UNIT																								
	309	1	SHELVING UNIT																								
	310	1	RACK, CAN																								
	311	1	RACK, CAN																								
	312	1	SHELVING UNIT																								
	313	1	SHELVING UNIT																								
	337	1	SHELVING UNIT																					</			

ABBREVIATIONS:			
AF	ABOVE FINISH FLOOR	HVAC	MECHANICAL CONTRACTOR
B/D	BPT OTHERS	HW	HOT WATER
CC	COLD WATER	HW	INDIRECT WASTE
DW	DIRECT WASTE	KEC	KITCHEN EQUIP. CONTRACTOR
DEA	DOWN FROM ABOVE	NRCC	NOT IN KITCHEN EQUIP. CONTRACT
EC	ELECTRICAL CONTRACTOR	PL	PLUMBING CONTRACTOR
EX	EXISTING	RL	REFRIGERATION LINE
F5	FLOOR SINK	S/S	STAINLESS STEEL
FSEC	FOOD SERVICE EQUIPMENT CONTRACTOR	SR	STEAM RETURN
FW	FILTER WATER	ST	STEAM SUPPLY
GC	GENERAL CONTRACTOR	VRY	VERIFY

- NOT FOR CONSTRUCTION -

THIS DRAWING IS AN INSTRUMENT OF SERVICE ONLY FOR THE LICENSED ARCHITECT
AND/OR ENGINEER ON THIS PROJECT.

PURSUANT TO FLORIDA STATUTE 481.229 SECTIONS 8A, 8B AND 8C, THESE DESIGNS, SPECIFICATIONS AND/OR LAYOUTS
CANNOT BE USED FOR CONSTRUCTION AND/OR INSTALLATION OF EQUIPMENT UNLESS REVIEWED AND APPROVED BY A
LICENSED ARCHITECT OR ENGINEER.

THESE DRAWINGS ARE PRELIMINARY AND CONCEPTUAL IN NATURE. THEY ARE PROVIDED FOR GENERAL INFORMATION
PURPOSES ONLY. ANYONE MAKING USE OF THESE DRAWINGS DOES SO AT THEIR OWN RISK AND ASSUMES ALL LIABILITY
FOR SUBSEQUENT USE.

FOODSERVICE EQUIPMENT SCHEDULE

DESIGN DEVELOPMENT KITCHEN DESIGN

CBI-22158

PALM BEACH COUNTY, FLORIDA



TRANSMITTED WITH IT CONTAINING LEGALLY PRIVILEGED AND CONFIDENTIAL TRADE SECRET INFORMATION SOLELY OWNED BY CHENY BROTHERS, INC. THE RECEIPT OF THIS DRAWING IS HERBY NOTIFIED OF ANY READING, DISSEMINATION, DISTRIBUTION, COPYING OR OTHER USE OF THESE DRAWINGS WITHOUT THE WRITTEN PERMISSION OF CHENY BROTHERS, INC. NO INFORMATION THAT IT CONTAINS MAY BE REPRODUCED OR DISCLOSED TO ANY PERSON NOT HAVING WRITTEN CONSENT FROM TIM WADDE, CHENY BROTHERS, INC. FURTHERMORE, ANY DISSEMINATION IN WHOLE OR IN PART OF THESE DRAWINGS FOR ANY PURPOSES OTHER THAN THAT FOR WHICH THEY WERE ORIGINALLY PREPARED OR FOR ANY PURPOSES OF CONSIDERING OR OBTAINING DAMAGES FOR ANY ERRORS OR OMISSIONS, ANY MATERIAL ENCLOSED HEREIN, OR ANY INFORMATION CONTAINED HEREIN, WITHOUT THE WRITTEN PERMISSION OF CHENY BROTHERS, INC. ASSUMES NO RESPONSIBILITY FOR ANY CHANGES REQUIRED BY THE USER OF THESE DRAWINGS. ANY CHANGES MUST BE MADE WITH ALL OTHER DRAWINGS ISSUED FOR THIS PROJECT.

DESIGN APPROVAL

REVISIONS AND MODIFICATIONS:		
NO.	DESCRIPTION:	DATE:
1	DESIGN ADJUSTMENTS	09/14/22
2	DESIGN ADJUSTMENTS: MEP & ELEVATIONS RELEASE	10/17/22
3	ADJUSTMENTS PER NEW ARCHITECTURAL BASE, ADDED ITEM 710.1	10/19/22
4	GENERAL REVISIONS: RENOV COOKING SUITE ITEM 700	11/23/22

SCALE: 1/4"=1'-0"

EQUIPMENT SCHEDULE																												
REVISION	ITEM NO	QTY	EQUIPMENT CATEGORY	EQUIPMENT REMARKS	VOLTS	CYCLE	PHASE	DIRECT	CORD PLUG	NEMA	AMPS	KW	HP	ELECTRICAL AFF (IN)	ELECTRICAL REMARKS	GAS MBTUH	COLD WATER SIZE (IN)	COLD WATER AFF (IN)	COLD WATER SIZE (IN)	COLD WATER AFF (IN)	HOT WATER SIZE (IN)	HOT WATER AFF (IN)	REFRAIN SIZE (IN)	REFRAIN AFF (IN)	INDR DRAIN SIZE (IN)	COMPRESSED AIR SIZE (IN)	COMPRESSED AIR AFF (IN)	PLUMBING REMARKS
	353	1	OVEN RACK, ROLL-IN																									
	354	1	OVEN RACK, ROLL-IN																									
	355	1	OVEN RACK, ROLL-IN																									
	368	1	CABINET, MOBILE, HOT OR COLD HOLDING		120	60	1		X	5-15P	9.1	1.1		18														
	369	1	CABINET, MOBILE, HOT OR COLD HOLDING		120	60	1		X	5-15P	9.1	1.1		18														
	370	1	CABINET, MOBILE, HOT OR COLD HOLDING		120	60	1		X	5-15P	9.1	1.1		18														
	371	1	CABINET, MOBILE, HOT OR COLD HOLDING		120	60	1		X	5-15P	9.1	1.1		18														
	372	1	CABINET, MOBILE, HOT OR COLD HOLDING		120	60	1		X	5-15P	9.1	1.1		18														
	373	1	CABINET, MOBILE, HOT OR COLD HOLDING		120	60	1		X	5-15P	9.1	1.1		18														
	374	1	CABINET, MOBILE, HOT OR COLD HOLDING		120	60	1		X	5-15P	9.1	1.1		18														
	375	1	CABINET, MOBILE, HOT OR COLD HOLDING		120	60	1		X	5-15P	9.1	1.1		18														
	376	1	CABINET, MOBILE, HOT OR COLD HOLDING		120	60	1		X	5-15P	9.1	1.1		18														
	377	1	CABINET, MOBILE, HOT OR COLD HOLDING		120	60	1		X	5-15P	9.1	1.1		18														
	400	1	WORK TABLE, W/ 2-PREP SINKS															1/2	14	1/2	14			211-1/2				
	400.1	1	SHELF, WALL MOUNT																									
	400.2	1	SHELF, WALL MOUNT																									
	401	1	PLANETARY MIXER, BENCH		115	60	1		X	5-15P	5.0		1/3	48														
	401.1	1	CAN OPENER		115	60	1		X	5-15P	1.5			48														
	402	1	WORKTABLE, STAINLESS STEEL TOP																									
	402.1	1	SHELF, WALL MOUNT																									
	402.2	1	SHELF, WALL MOUNT																									
	403	1	WORK TABLE, W/ 2-PREP SINKS															1/2	14	1/2	14			211-1/2				
	403.1	1	SHELF, WALL MOUNT																									
	403.2	1	SHELF, WALL MOUNT																									
	404	1	MIXER, FLOOR		208	60	3		X	L15-20P	9.0		3.0	18														
	405	1	SHELVING UNIT																									
	405.1	1	REVERSE OSMOSIS SYSTEM															3/4	102								SERVES ITEM 205	
	405.2	1	REVERSE OSMOSIS SYSTEM															3/4	102								SERVES ITEM 206	
	405.3	1	REVERSE OSMOSIS SYSTEM															3/4	82								SERVES ITEM 207	
	405.4	1	REVERSE OSMOSIS SYSTEM															3/4	82								SERVES ITEM 208	
	406	1	RACK, PAN																									
	407	1	RACK, PAN																									
	408	1	RACK, PAN																									
	409	1	RACK, PAN																									
	410	1	RACK, PAN																									
	411		SPARE NUMBER																									
	412		SPARE NUMBER																									
	413	1	CABINET, MOBILE, HOT OR COLD HOLDING		120	60	1		X	5-15P	9.1	1.1		18														
	414	1	CABINET, MOBILE, HOT OR COLD HOLDING		120	60	1		X	5-15P	9.1	1.1		18														
	415	1	CABINET, MOBILE, HOT OR COLD HOLDING		120	60	1		X	5-15P	9.1	1.1		18														
	416	1	CABINET, MOBILE, HOT OR COLD HOLDING		120	60	1		X	5-15P	9.1	1.1		18														
	417	1	CABINET, MOBILE, HOT OR COLD HOLDING		120	60	1		X	5-15P	9.1	1.1		18														
	418	1	CABINET, MOBILE, HOT OR COLD HOLDING		120	60	1		X	5-15P	9.1	1.1		18														
	419	1	CABINET, MOBILE, HOT OR COLD HOLDING		120	60	1		X	5-15P	9.1	1.1		18														
	420		SPARE NUMBER																									
	421		SPARE NUMBER																									
	422		SPARE NUMBER																									
	423	1	HAND SINK, WALL MOUNT															1/2	14	1/2	14	1-1/2						
	424	1	CHILLER, BLAST, ROLL-IN		115-208	60	1		X		24.0	5.5	3	102											1			
	425	1	CHILLER, BLAST, ROLL-IN		115-208	60	1		X		24.0	5.5	3	102												1		
	426	1	HAND SINK, WALL MOUNT															1/2	14	1/2	14	1-1/2						
	500	1	SOILED DISHTABLE W/SCRAP SINK, CUSTOM	REFER TO SHOP DRAWINGS														1/2	14	1/2	14	1-1/2						
	501	1	DISPOSER, W/ RECIRCULATING PRE-RINSE		208	60	3		X		12.7		3.0	18				1/2	14	1/2	14	2 & 3						3/4" HW & 3/4" CW SERVICE, REDUCE AT CONNECTION
	502	1	WAREWASHER, DOOR TYPE, HIGH TEMP	W/BOOSTER HEATER; WIDRAIN WATER TEMPERING KIT	480	60	3		X		25.0			76"	* JB @12" ABOVE FINISHED CEILING CONNECTED TO NEMA-3-R DISCONNECT SWITCH.			1/2	14	3/4	76							MINIMUM 140°F HOT WATER FROM BUILDING WATER HEATER
	503	1	CONDENSATE HOOD	REFER TO SHOP DRAWINGS WHEN AVAILABLE											VERIFY UTILITIES W/SHOP DRAWINGS WHEN AVAILABLE													VERIFY UTILITIES W/SHOP DRAWINGS WHEN AVAILABLE
	504		SPARE NUMBER																									
	505	1	CLEAN DISHTABLE, CUSTOM	REFER TO SHOP DRAWINGS																								
	506	1	HAND SINK, WALL MOUNT															1/2	14	1/2	14	1-1/2						
	507	1	DISPENSER, BEER		120	60	1		X	5-15P	1.8		1/6	18														
	508	1	SHELVING UNIT																									
	509	1	SHELVING UNIT																									
	510	1	DISHTABLE POWWER WASH	LEFT TO RIGHT	208	60	3		X		26.7		2.0	18				(2)3/4 1/2	14 10	(2)3/4 1/2	14 10			(3)1-1/2				(2)HIGH-FLOW FAUCETS; VERIFY WITH SHOP DRAWING PRE-RINSE FAUCET; VERIFY WITH SHOP DRAWING
	510.1	1	SHELF, WALL MOUNT																									
	510.2	1	SHELF, WALL MOUNT																									
	510.3	1	SHELF, WALL MOUNT																									
	510.4	1	SHELF, WALL MOUNT																									
	511	1	BEER COOLING SYSTEM	WALL MOUNTED WITH BOTTOM AT 7'-0"	120	60	1		X		15.7		1/2	90	25 AMPS MAXIMUM OVERCURRENT PROTECTION													
	550	1	MOP SINK STORAGE CABINET	W/SERVICE FAUCET; INLETS @ 36" AFF																								

EQUIPMENT SCHEDULE																											
REVISION	ITEM NO	QTY	EQUIPMENT CATEGORY	EQUIPMENT REMARKS	VOLTS	CYCLE	PHASE	DIRECT	CORD/PLUG	NEUMA	AMPS	KV	HP	ELECTRICAL AFF (IN)	ELECTRICAL REMARKS	GAS MBTU/H	GAS SIZE (IN)	STEAM AFF (IN)	COLD WATER SIZE (IN)	COLD WATER AFF (IN)	COLD WATER SIZE (IN)	HOT WATER AFF (IN)	DIRECT DRAIN SIZE (IN)	INDUR DRAIN SIZE (IN)	COMPRESSED AIR SIZE (IN)	COMPRESSED AIR AFF (IN)	PLUMBING REMARKS
	601	1	COOK/CHILL, AUTOMATIC CHILL TANK		208	60	3	X			21.0			18					3/4	14							
⚠	601.1	1	REMOTE CONDENSING UNIT	LOCATION TO BE DETERMINED	460	60	3	X		-		-	18	36 MCA, 60 MOP													
	602	1	HEAT SEALER WITH CONVEYOR		120	60	1		X	-	10.0			18													
	603	1	CRATE DOLLY																								
	603.1	1	CHILL CRATE																								
	603.2	1	CHILL CRATE																								
	604	1	CRATE DOLLY																								
	604.1	1	CHILL CRATE																								
	604.2	1	CHILL CRATE																								
	605	1	SPARE NUMBER																								
	606	1	POWER WASH SINK		208/230	60	1	X			5.2/4.8		3/4	18	15 AMPS BREAKER REQUIRED				1/2	14	1/2	14		1-1/2			
	607	1	WORKTABLE W/2-SINKS & HAND SINK, CUSTOM	REFER TO SHOP DRAWINGS															1/2	14	1/2	14		2 1/2-1-1/2			PREP SINKS
	607.1	1	SHELF, WALL MOUNT																1/2	14	1/2	14		1-1/2			HAND SINK
	607.2	1	SHELF, WALL MOUNT																								
	608	1	FOOD PROCESSOR, FLOOR MODEL		208	60	3		X	L15-20P	6.5		3.0	18													
	608.1	1	WORKSTATION STORAGE CART																								
	609	1	POTATO AND VEGETABLE PEELER		115-230	60	1		X	--	--		1.0	18					1/2	14				2			
	610	1	MACHINE VEGETABLE DRYER		120	60	1		X	5-15P	2.7	0.4	1/2	18													
	611	1	AIR CURTAIN, UNHEATED	W/ MAGNETIC REED DOOR SWITCH	120	60	1		X	5-15P	3.4		1/5	102	MOUNT OUTLET ABOVE UNIT												
	612	1	AIR CURTAIN, UNHEATED	W/ MAGNETIC REED DOOR SWITCH	120	60	1		X	5-15P	3.4		1/5	102	MOUNT OUTLET ABOVE UNIT												
	613	1	HOSE REEL ASSEMBLY	W/STAINLESS STEEL WALL RECESSED CABINET															1/2	56	1/2	56					UTILITIES DOWN FROM ABOVE & INSIDE WALL
	614	1	HAND SINK, WALL MOUNT																1/2	14	1/2	14	1-1/2				
	615	1	ACUMULATOR TABLE (BY OTHERS)		110	60	1	--	--		6		*		* FLOOR RECEPTACLE @ 4" AFF												
	616	1	INTERMITTENT-MOTION SEALING SYSTEM (BY OTHERS)		120	60	1	--	--		6		*		* FLOOR RECEPTACLE @ 4" AFF												
	617	1	WORKTABLE, STAINLESS STEEL TOP																								
	618	1	PLATING CONVEYOR SYSTEM		120	60	1		X	L5-15P	15.0	6.24		18													
	619	1	WORKTABLE, STAINLESS STEEL TOP																								
	620	1	WORKTABLE, STAINLESS STEEL TOP																								
	621	1	WORKTABLE, STAINLESS STEEL TOP																								
	622	1	WORKTABLE, STAINLESS STEEL TOP																								
	623	1	SPARE NUMBER																								
	624	1	SPARE NUMBER																								
	625	1	WORKTABLE, STAINLESS STEEL TOP																								
	626	1	INTERMITTENT-MOTION SEALING SYSTEM		120	60	1	--	--		6		*		* FLOOR RECEPTACLE @ 4" AFF												
	627	1	ACUMULATOR TABLE (BY OTHERS)		110	60	1	--	--		6		*		* FLOOR RECEPTACLE @ 4" AFF												
⚠	700	1	COOKING SUITE WHAND SINK & LOAD CENTER, CUSTOM	REFER TO SHOP DRAWINGS															1/2	14	1/2	14	1-1/2				
⚠	701	1	END CABINET (PART OF ITEM 700)																								
⚠	702	1	TITAN 36", 24" CHARBROILER, (2) 12" OPEN BURNERS, & CONVECTION OVEN (PART OF ITEM 700)	REFER TO SHOP DRAWINGS	120	60	1		X		4.4		*		* POWER FROM LOAD CENTER	160	*	*									* GAS MANIFOLDED WITHIN TABLE, ONLY (1) FEED REQUIRED
⚠	703	1	REFRIGERATED BASE (PART OF ITEM 700)	REFER TO SHOP DRAWINGS	120	60	1		X		12.6		*		* POWER FROM LOAD CENTER												* GAS MANIFOLDED WITHIN TABLE, ONLY (1) FEED REQUIRED
⚠	704	1	(2) 12" OPEN BURNERS, MODULAR (PART OF ITEM 700)	REFER TO SHOP DRAWINGS												70	*	*									
⚠	705	1	SPREADER CABINET (PART OF ITEM 700)																								
⚠	706 / 708	1	MODIFIED TITAN 36", (4) 12" OPEN BURNERS, 24" SPANISH STYLE PLANCHA & CONVECTION OVEN (PART OF ITEM 700)	REFER TO SHOP DRAWINGS	120	60	1		X		4.4		*		* POWER FROM LOAD CENTER	187.5	*	*									* GAS MANIFOLDED WITHIN TABLE, ONLY (1) FEED REQUIRED
⚠	707	1	REFRIGERATED BASE (PART OF ITEM 700)	REFER TO SHOP DRAWINGS	120	60	1		X		12.6		*		* POWER FROM LOAD CENTER												
⚠	709	1	END CABINET (PART OF ITEM 700)																								
⚠	710	1	CABINET, COOK & HOLD		208	60	1		X		24.0	5	*		* CONNECTED TO RECEPTACLE IN ITEM 700; POWER FROM LOAD CENTER				1/4	12			1/2				FILTERED COLD WATER FROM ITEM 710.1
⚠	710.1	1	WATER FILTER																1/2	12							SERVES ITEM 710
	711	1	REFRIGERATOR, UNDERCOUNTER, COMPACT		120	60	1		X	5-15P	5.3		1/4	18													
	712	1	CUSTOM CABINET BASE, CUSTOM	REFER TO SHOP DWGS, STONE COUNTERTOP BY OTHERS																							
⚠	713	1	ESPRESSO CAPPUCCINO MACHINE		208-240	60	1			L6-30P	13.0	3.1		48					1/4	48				1			FILTERED WATER FROM ITEM 713.1
	713.1	1	MILK REFRIGERATOR		120	60	1		X	5-15P	--			48													
⚠	713.1	1	WATER FILTER																3/8	96							SERVES ITEM 713
	714	1	SINK, UNDERMOUNT																1/2	14	1/2	14		2 1/2-1-1/2			
⚠	715	1	DISPENSING HEAD, DRAFT BEER, TEE TOWER	COUNTER MOUNTED																							
⚠	715.1	1	DRIP PAN																					1/2			
	716	1	REFRIGERATOR, UNDERCOUNTER, COMPACT		120	60	1		X	5-15P	5.3		1/4	18													
	717	1	WINE REFRIGERATOR/COOLER		115	60	1		X	5-15P	8.4		(2)1/4	90	15 AMPS BREAKER REQUIRED												
	718	1	BEER GLASS STORAGE W/3 SHELVES (MILLWORK)																								
	719	1	COUNTER W/CABINET BASE (MILLWORK)																								
	720	1	WINE GLASS STORAGE W/3 SHELVES (MILLWORK)																								
	721	1	EXHAUST HOOD	REFER TO SHOP DRAWINGS WHEN AVAILABLE											VERIFY UTILITIES W/ SHOP DRAWINGS WHEN AVAILABLE												
	CO-1	TBD	CONVENIENCE OUTLET	GENERAL PURPOSE 120V RECEPTACLE	120	60	1		X	5-15R	16.0			48	VERIFY W/ MEP DRAWINGS												
	CO-1	TBD	CONVENIENCE OUTLET	GENERAL PURPOSE 120V RECEPTACLE	120	60	1		X	5-15R	16.0			*	VERIFY W/ MEP DRAWINGS; "DROP CORD @+60"												

ABBREVIATIONS:			
AFF	ABOVE FINISH FLOOR	HVAC	MECHANICAL CONTRACTOR
B.O.	BY OTHERS	HW	HOT WATER
CW	COLD WATER	IW	INDIRECT WASTE
DW	DIRECT WASTE	KEC	KITCHEN EQUIP. CONTRACTOR
DFA	DOWN FROM ABOVE	NKEC	NOT IN KITCHEN EQUIP. CONTRACT
EC	ELECTRICAL CONTRACTOR	PC	PLUMBING CONTRACTOR
EX	EXISTING	RL	REFRIGERATION LINE
FS	FLOOR SINK	S/S	STAINLESS STEEL
FS&C	FOOD SERVICE EQUIPMENT CONTRACTOR	SR	STEAM RETURN
FW	FILTER WATER	SS	STEAM SUPPLY
GC	GENERAL CONTRACTOR	VRFY.	VERIFY

- NOT FOR CONSTRUCTION -

THIS DRAWING IS AN INSTRUMENT OF SERVICE ONLY FOR THE LICENSED ARCHITECT AND/OR ENGINEER ON THIS PROJECT.	DATE: 09-06-2022
PURSUANT TO FLORIDA STATUTE 481.229 SECTIONS 8A, 8B AND 8C THESE DESIGNS, SPECIFICATIONS AND/OR LAYOUTS CANNOT BE USED FOR CONSTRUCTION AND/OR INSTALLATION OF EQUIPMENT UNLESS REVIEWED AND APPROVED BY A LICENSED ARCHITECT OR ENGINEER.	DRAWN: SC / jv
THESE DRAWINGS ARE PRELIMINARY AND CONCEPTUAL IN NATURE THEY ARE PROVIDED FOR GENERAL INFORMATION PURPOSES ONLY. ANYONE MAKING USE OF THESE DRAWINGS DOES SO AT THEIR OWN RISK AND ASSUMES ALL LIABILITY FOR SUBSEQUENT USE.	CHECKED: -
	PM: JC
	JOB No.: CBI-22158
	SHEET: K1-1.4

FOODSERVICE EQUIPMENT SCHEDULE

DESIGN DEVELOPMENT
KITCHEN DESIGN

CBI-22158

PALM BEACH COUNTY, FLORIDA



Cheney Brothers

EQUIPMENT & DESIGN DIVISION

2051 N. U.S. 1, SUITE 100
Ft. Pierce, FL 34941
1-877-CBI-4457 (224-7433) www.cheneybrothers.com

THIS DRAWING, INTELLECTUAL PROPERTY, AND ALL ATTACHMENTS ARE THE SOLE PROPERTY OF CHENEY BROTHERS, INC. NO PART OF THIS DRAWING OR ANY INFORMATION CONTAINED HEREIN IS TO BE REPRODUCED OR TRANSMITTED IN ANY FORM OR BY ANY MEANS, ELECTRONIC OR MECHANICAL, INCLUDING PHOTOCOPYING, RECORDING, OR BY ANY INFORMATION STORAGE AND RETRIEVAL SYSTEM, WITHOUT THE WRITTEN PERMISSION OF CHENEY BROTHERS, INC. ANY INFORMATION CONTAINED HEREIN IS UNCLASSIFIED AND NOT FOR OFFICIAL USE ONLY. ANY INFORMATION CONTAINED HEREIN IS UNCLASSIFIED AND NOT FOR OFFICIAL USE ONLY. ANY INFORMATION CONTAINED HEREIN IS UNCLASSIFIED AND NOT FOR OFFICIAL USE ONLY.





DESIGN APPROVAL

☐ APPROVED ☐ APPROVED AS NOTED ☐ RESUBMIT TO NEW DESIGN

APPROVED BY: _____ DATE: _____

TITLE: _____

NO.	DESCRIPTION	DATE
1	DESIGN APPROVALS	09/17/22
2	REVISIONS	10/17/22
3	REVISIONS	10/17/22
42	REVISIONS	10/

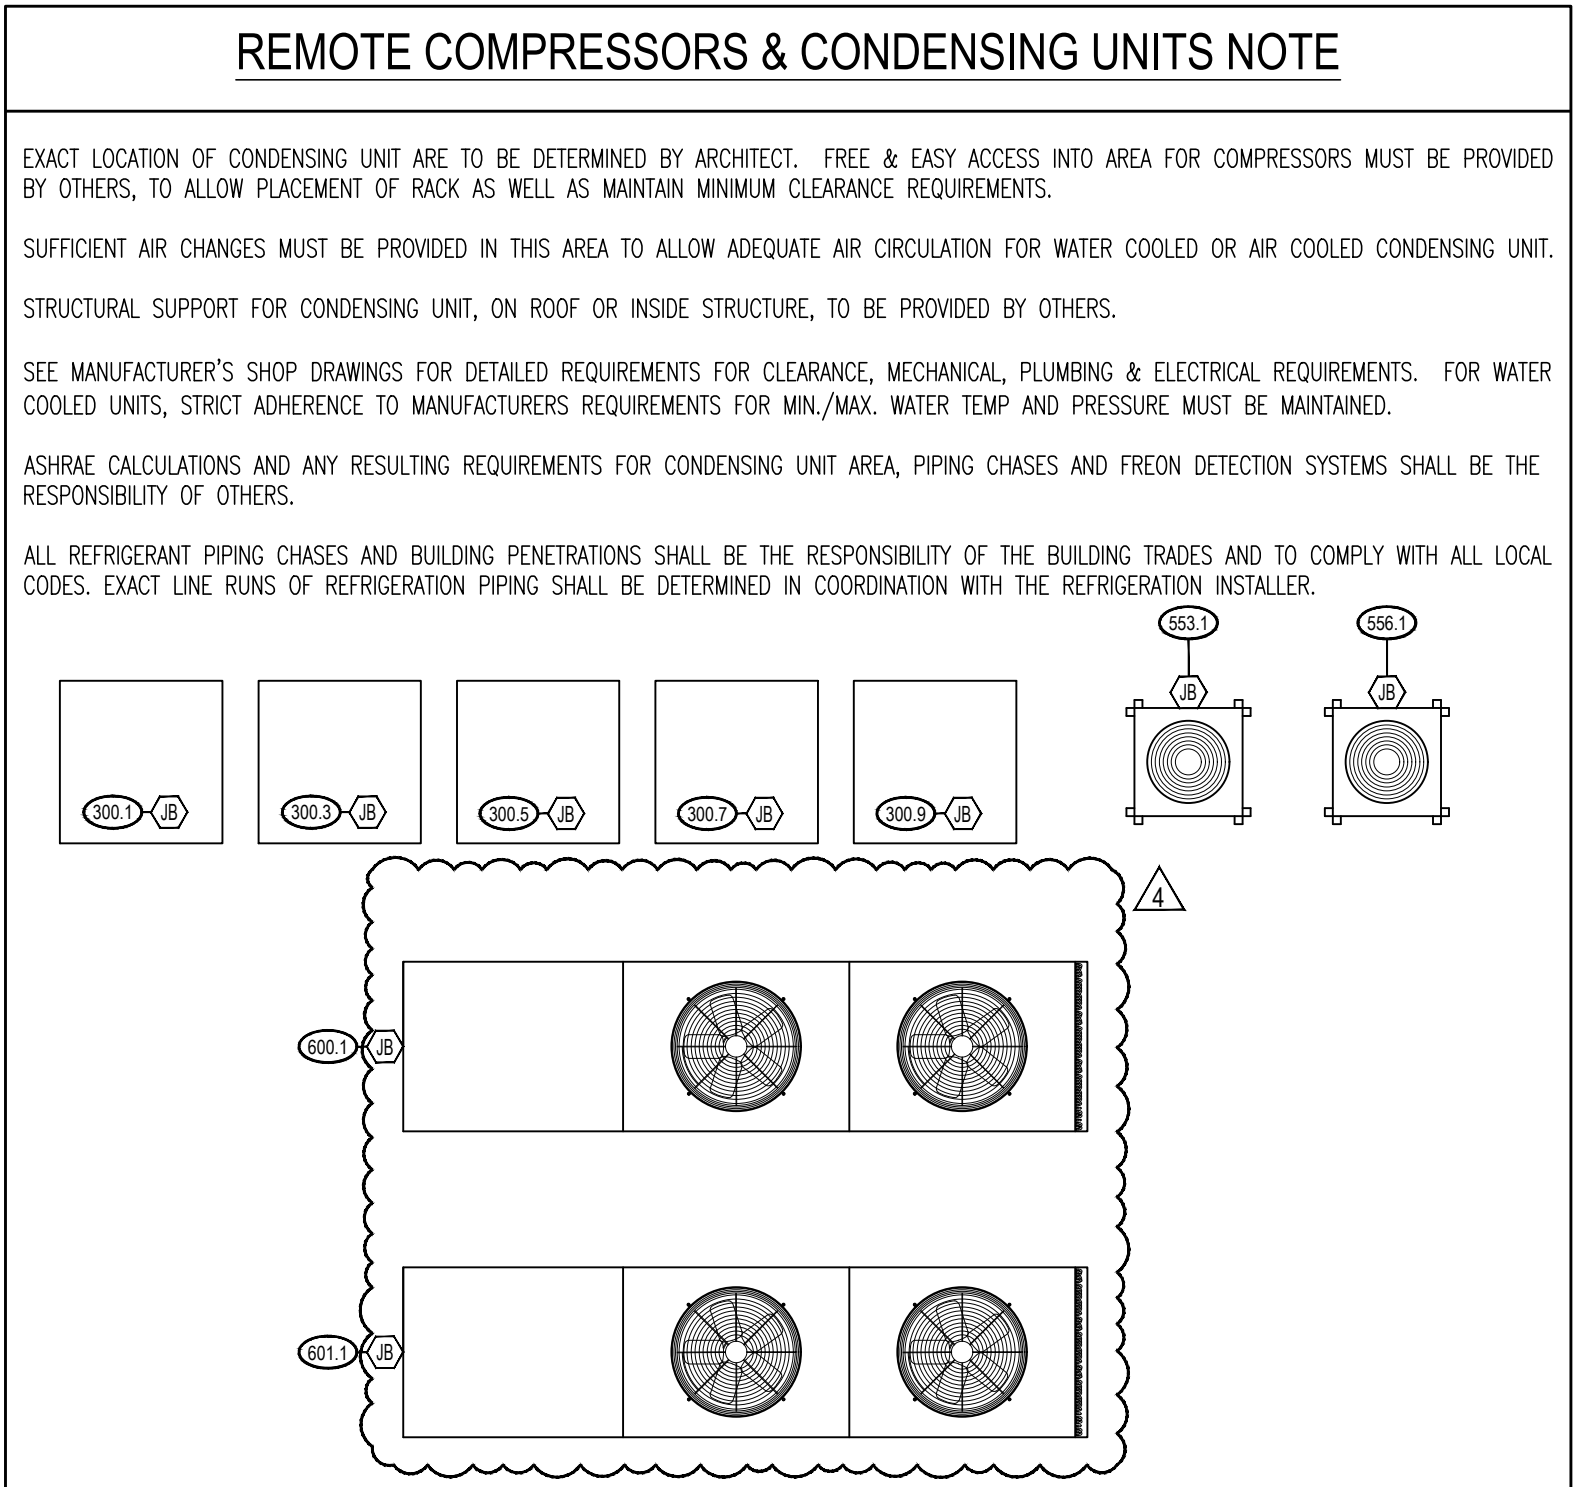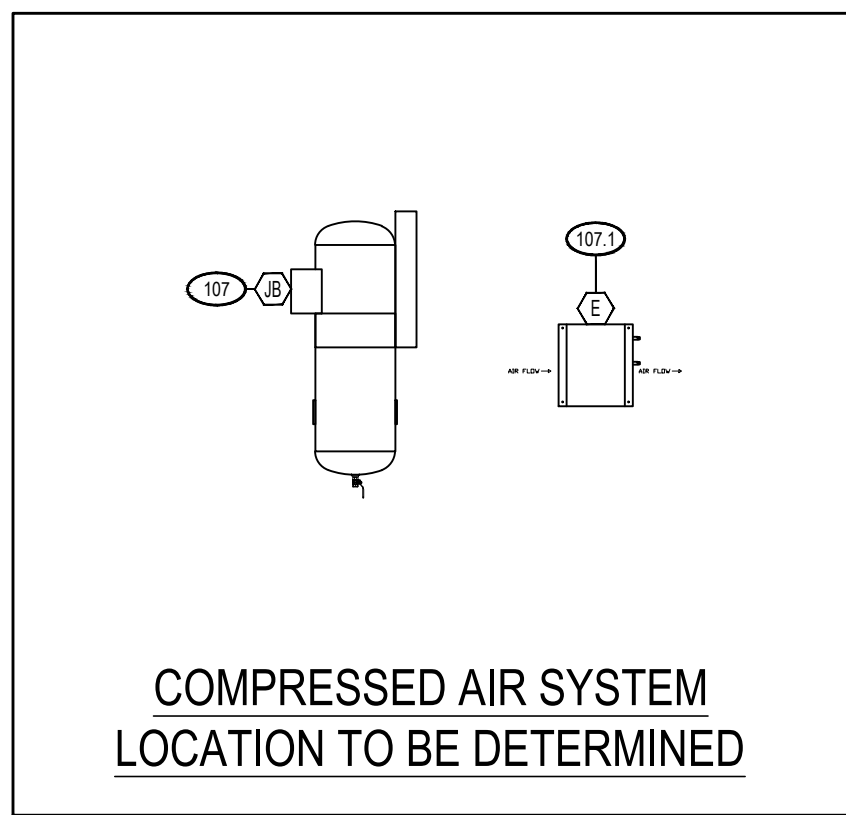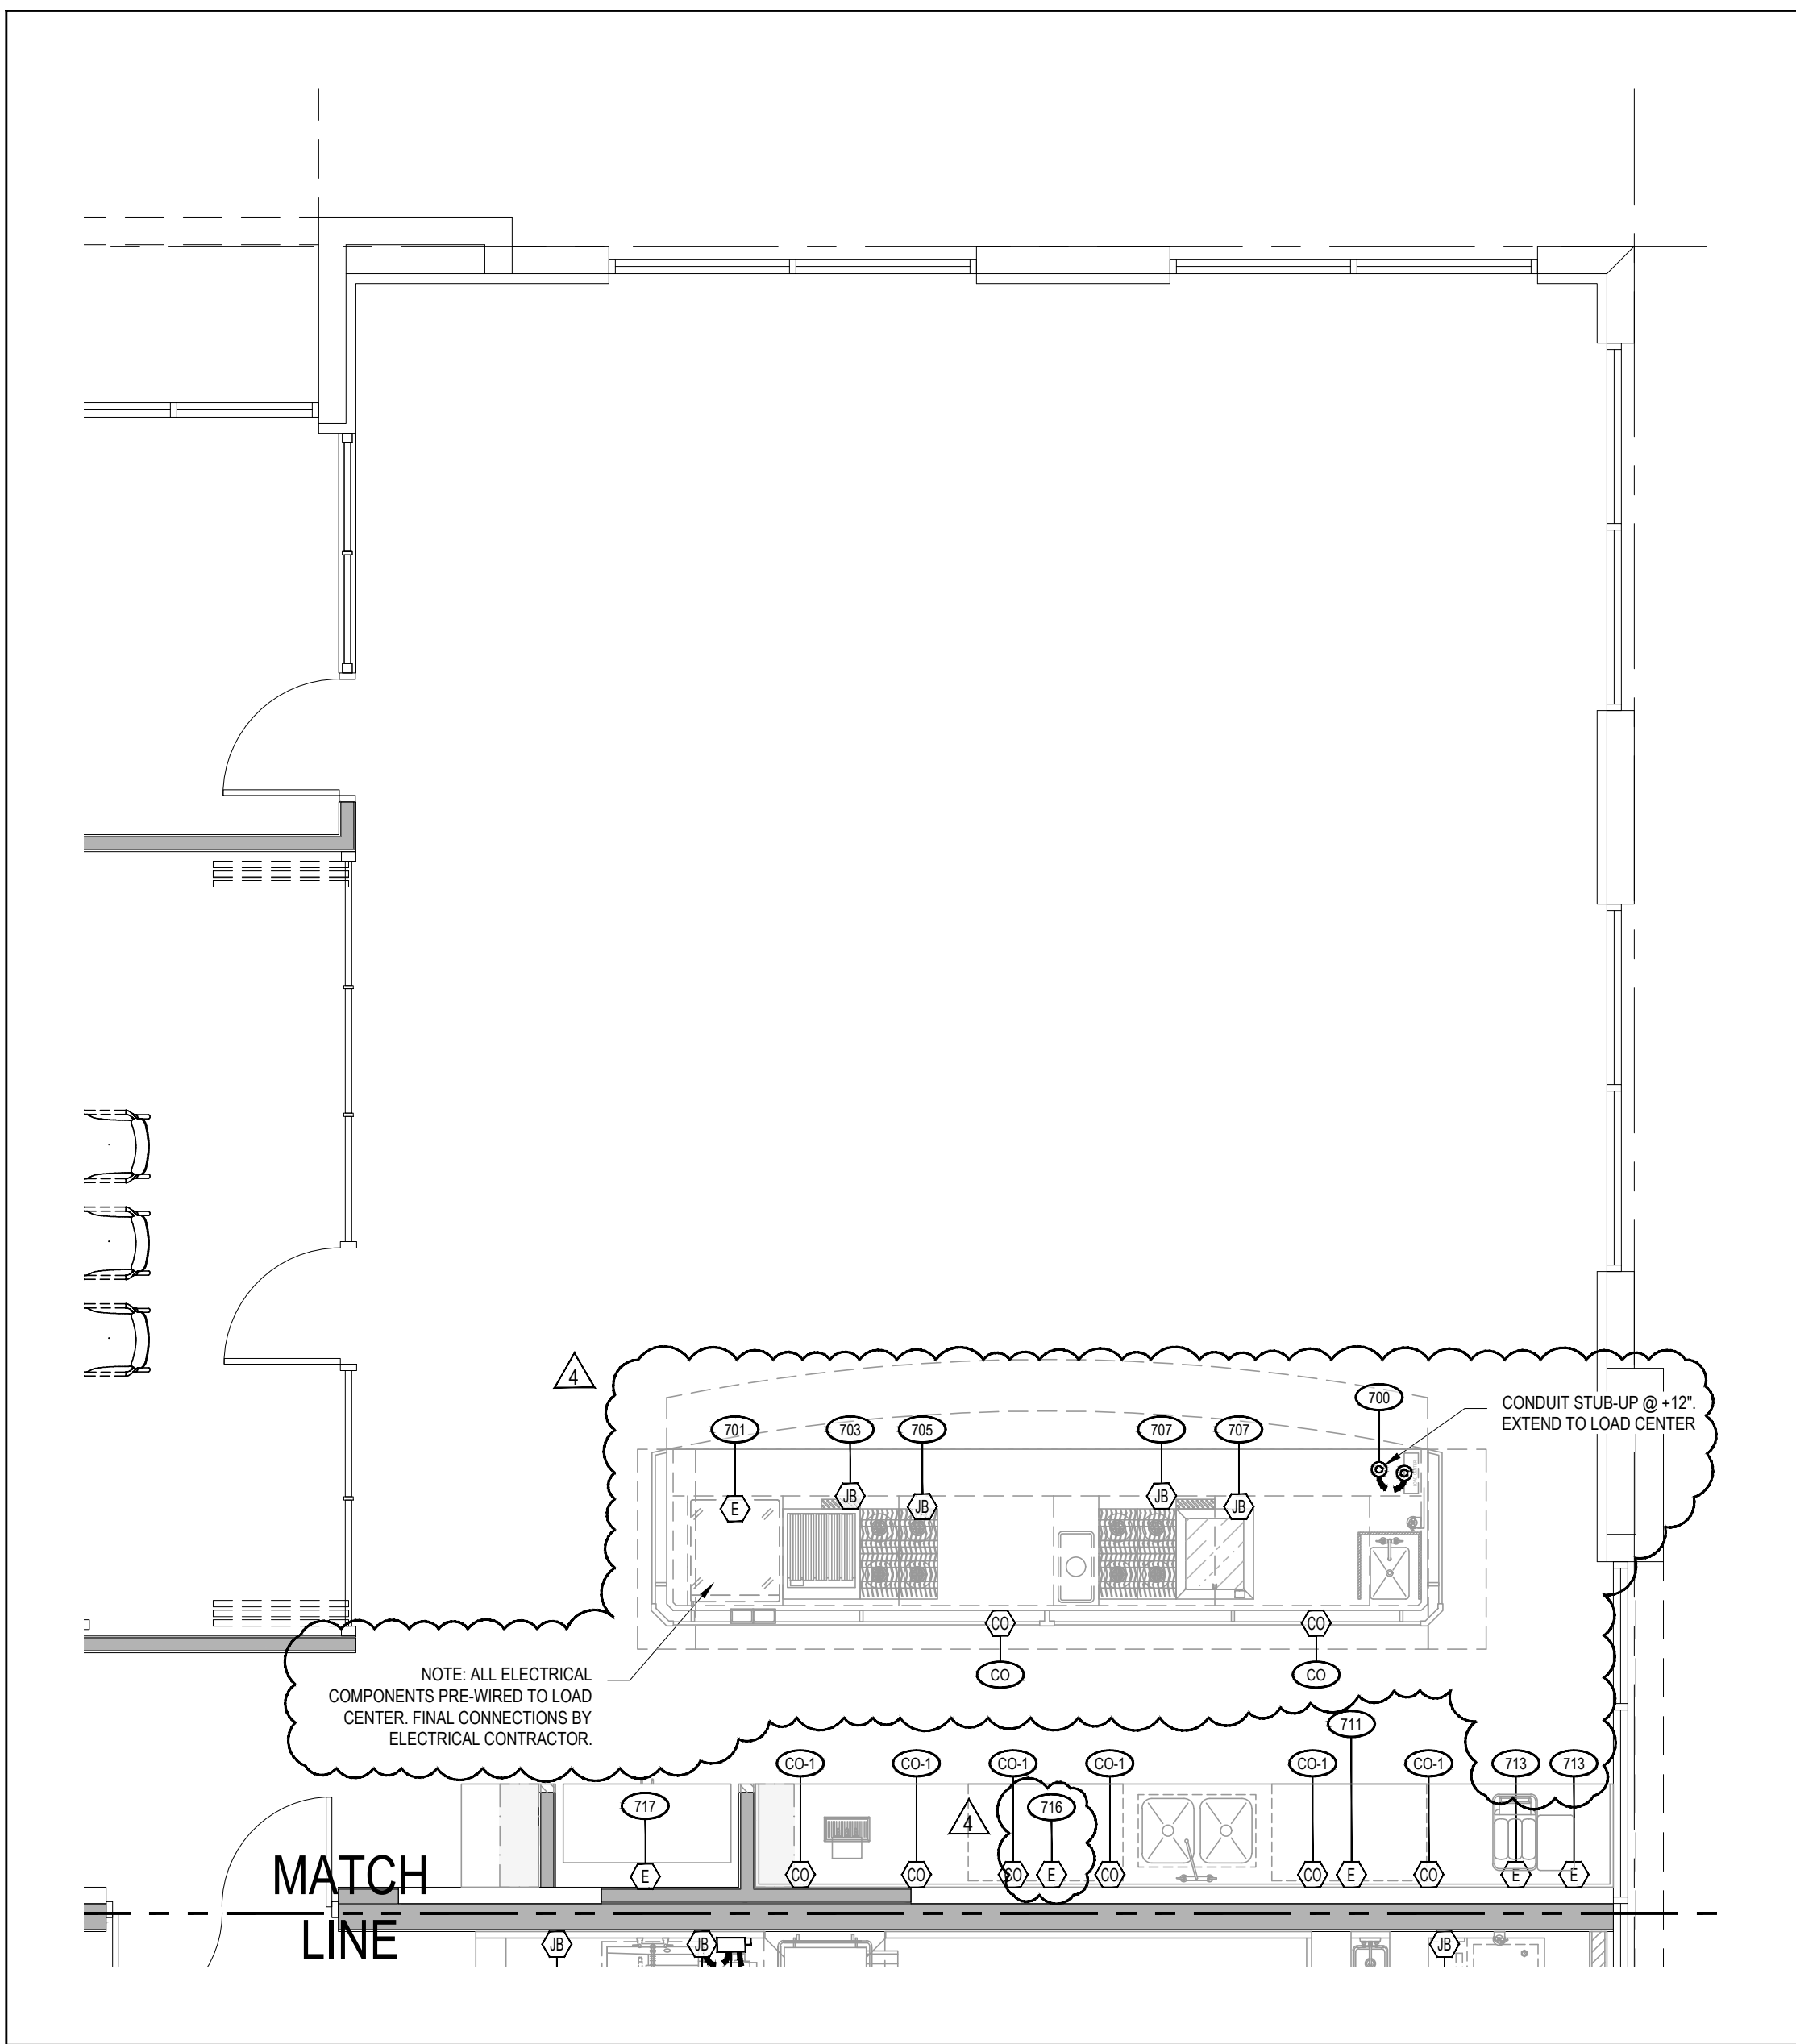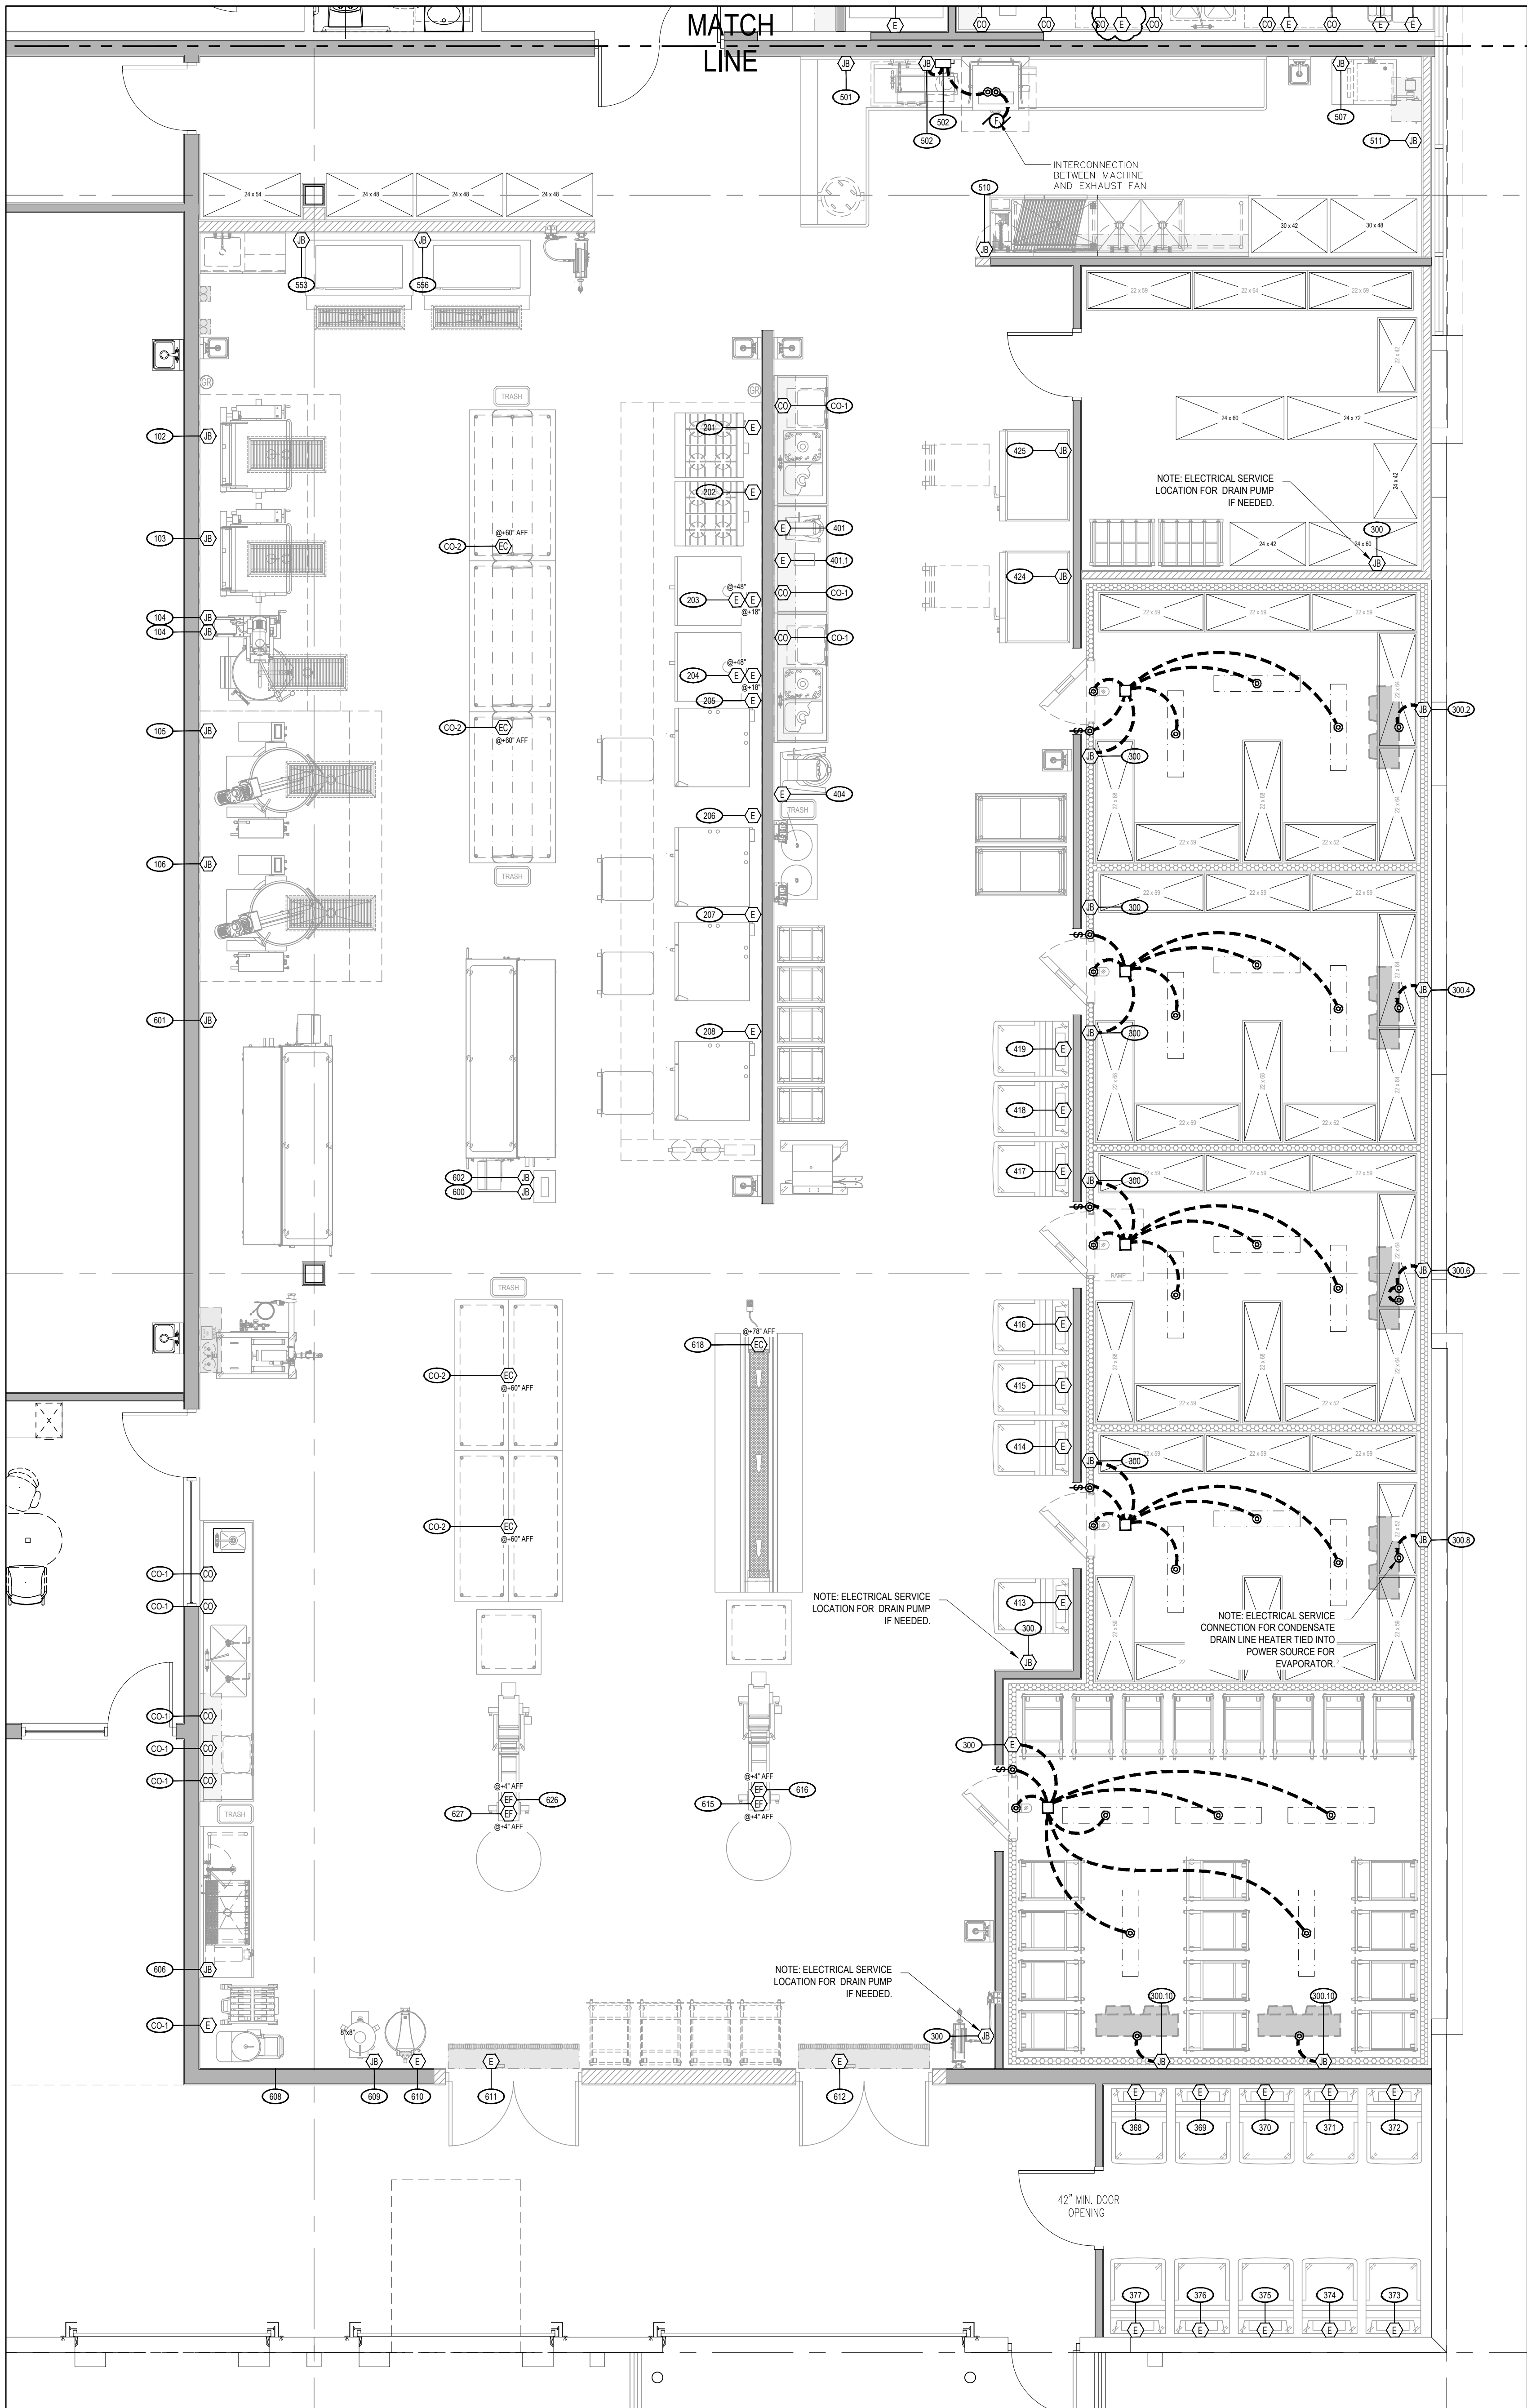

ELECTRICAL PLAN LEGEND:	
E	TYPICAL SERVICE LOCATION
ED	CEILING SERVICE LOCATION
EF	FLOOR ELECTRICAL SERVICE
JB	JUNCTION BOX
CO	SUGGESTED CONVENIENCE OUTLET LOCATION (VERIFY WITH MEP DRAWINGS)
001	SCHEDULE REFERENCE NUMBER
	ELECTRICAL CONNECTION LOCATION
	SAFETY DISCONNECT SWITCH (S.D.S.) BY EC - VERIFY/COORDINATE LOCATION
	SWITCH LOCATION
	FAN

ADDITIONAL OUTLETS (CONVENIENCE OUTLETS) AND OUTLETS FOR EQUIPMENT NOT SHOWN ON THIS PLAN MAY BE NEEDED TO COMPLY WITH ANY CODE OR OWNER ELECTRICAL REQUIREMENTS (REFER TO M.E.P. DRAWINGS).

ELECTRICAL CONTRACTOR TO SUPPLY FIRE SUPPRESSION SYSTEM w/ ADEQUATE NUMBER OF DRY CONTACTS (MICRO-SWITCHES) TOO INTERWIRE SHUNT TRIP, GAS VALVES, BUILDING ENUNCIATOR AND FAN CONTROLLER. ALL INTERWIRING OF DEVICES IS TO BE IN ACCORDANCE WITH LOCAL AND NATIONAL CODES. ALL WIRING TO BE BY ELECTRICAL CONTRACTOR.

ELECTRICIAN SHALL WIRE FROM SWITCH ON CONTROL PANEL TO ROOF MOUNTED EXHAUST AND SUPPLY FANS AND TO LIGHT JUNCTION BOX LOCATED ON TOP OF CANOPY. CIRCUITS SHALL BE INTERWIRED SO LIGHT AND FAN WILL EITHER BE ON OR OFF AT THE SAME TIME.

THE ELECTRICAL CONTRACTOR SHALL SUPPLY ANY AND ALL MATERIAL, JUNCTION BOXES, DISCONNECTS, RECEPTACLES, CORDS, CORD CAPS, CONDUITS, SWITCHES, WIRING AND WIRING CAPS NEEDED TO COMPLETE INSTALLATION OF THE KITCHEN EQUIPMENT SHOWN ON THIS PLAN.

ELECTRICAL CONTRACTOR SHALL BE RESPONSIBLE FOR REVIEWING ALL FOOD SERVICE DOCUMENTS TO ENSURE THAT ALL REQUIRED ELECTRICAL SERVICES (SUPPLIED IN THE MANUFACTURER'S CUT SHEETS) AND PLANS TO ENSURE THAT ALL REQUIRED ELECTRICAL SERVICES ARE PROVIDED SO AS TO COMPLETE THE PROJECT.

ELECTRICAL CONTRACTOR TO PROVIDE SERVICE AND FULLY OPERATIONAL EQUIPMENT ITEMS.

ALL WORK TO BE DONE IN ACCORDANCE WITH ALL APPLICABLE NATIONAL AND/OR LOCAL ELEC. CODES. ALL RECEPTACLES SHALL BE GROUNDED PER N.E.C. AND O.S.H.A. REQUIREMENTS.

ELECTRICAL GENERAL NOTES	
1.	THIS DRAWING IS ACCOMPANIED BY OTHER DRAWINGS, SPECIFICATIONS AND BROCHURES. DRAWINGS SPECIFICATIONS AND BROCHURES ARE TO BE CONSIDERED A WHOLE FOR BRUSHING, ROUGH-IN, INSTALLATION AND CONNECTIONS. THE GENERAL CONTRACTOR SHALL PREVIEW THESE DOCUMENTS FOR NOTATIONS AND COMMENTS THAT PERTAIN TO THE ASPECTS OF THE PROJECT.
2.	GENERAL CONTRACTOR IS TO REFER TO MANUFACTURER'S BROCHURES AND SPECIFICATIONS FOR ADDITIONAL DATA PRIOR TO STARTING ROUGH-INS. ALL RECEPTACLES, CORDS, CORD CAPS, CONDUITS, SWITCHES AND WIRING ARE TO BE PROVIDED BY THE ELECTRICAL CONTRACTOR UNLESS OTHERWISE SPECIFIED. ALL WORK TO BE DONE IN ACCORDANCE WITH NATIONAL/LOCAL CODES.
3.	GENERAL CONTRACTOR SHALL BE RESPONSIBLE FOR REVIEWING ALL FOOD SERVICE DOCUMENTS TO ENSURE THAT ALL REQUIRED ELECTRICAL SERVICES ARE PROVIDED SO AS TO COMPLETE THE PROJECT.
4.	ELECTRICAL WIRING FOR FIRE PROTECTION, GAS SOLENOID (IF ELECTRICAL) AND/OR SHUNT TRIP BREAKERS ARE THE RESPONSIBILITY OF THE ELECTRICAL CONTRACTOR.
5.	ELECTRICAL REQUIREMENT FOR FIRE PROTECTION, GAS SOLENOID AND/OR SHUNT TRIP BREAKERS TO BE WIRED THRU LIFE SAFETY SYSTEM BY ELECTRICAL CONTRACTOR.
6.	ELECTRICAL WIRING AND SUPPLY LINES SHOWN ON THESE DRAWINGS, UNLESS OTHERWISE SPECIFIED IN DETAILS, ARE SCHEMATIC IN NATURE AND WILL BE INSTALLED BY THE GENERAL CONTRACTOR.
7.	FABRICATED EQUIPMENT CONTAINING A BREAKER PANEL OR LOAD CENTER OR EQUIPMENT INDICATED SO, SHALL BE PRE-WIRED BY FABRICATOR READY FOR FIELD CONNECTION TO ONE POINT BY THE ELECTRICAL CONTRACTOR.
8.	ELECTRICAL CONTRACTOR TO PROVIDE SERVICE AND FULLY CONNECTED EQUIPMENT ITEMS, UNLESS SPECIFIED OTHERWISE IN DETAILS, AND SHALL FURNISH AND INSTALL ALL MATERIAL, JUNCTION BOXES, DISCONNECTS, SWITCHES, STARTERS, BREAKER PANELS, LAMPS, ETC. AND PIPING BETWEEN EQUIPMENT LOCATION AND SUB-OUT TO MAKE EQUIPMENT FULLY OPERATIONAL. ALL DEVICES TO MEET N.E.C. AND O.S.H.A. REQUIREMENTS.
9.	ALL RECEPTACLES SHALL BE GROUNDED PER N.E.C. AND O.S.H.A. REQUIREMENTS.
10.	ELECTRICAL PLAN IS INTENDED TO INDICATE ROUGH-IN LOCATIONS, CONNECTION POSITIONS, AND LOAD REQUIREMENTS FOR FINAL ROUGH-IN/IMP. EQUIPMENT INDICATED IN THE FOOD SERVICE EQUIPMENT CONTRACTOR SCOPE OF WORK. ADDITIONAL ELECTRICAL SERVICE MAY BE REQUIRED BY ARCHITECT OR OWNER.
11.	PIPING SHALL BE CONCEALED IN WALLS WHEREVER POSSIBLE. SUB-OUT DIMENSIONS ARE FROM FINISHED WALLS TO CENTER OF SUB-OUTS OF FROM CENTER OF SUB-OUT TO CENTER OF SUB-OUT.
12.	SUB-OUT HEIGHTS ARE TO BE MEASURED FROM THE FINISHED FLOOR, NOT FROM CURBS OR PADS, TO THE CENTERLINE OF THE SUB-OUT. SUB-OUTS SHALL EXTEND 4" BEYOND WALLS.
13.	GENERAL CONTRACTOR TO FURNISH AND INSTALL WALL AND FLOOR SLEEVES. FLOOR SLEEVES SHALL BE WATER TIGHT AND EXTEND 1" ABOVE FINISH FLOOR. SLEEVES THROUGH PADS AND CURBS TO BE FLUSH. SEAL SLEEVE OPENINGS WATER TIGHT.
14.	GENERAL CONTRACTOR SHALL BE RESPONSIBLE FOR REMOVING AND RE-INSTALLING, REPAIRING OR REPLACING EXISTING ACoustical, GYPSUM OR OTHER CEILING, WALLS OR FLOORS AS REQUIRED FOR THE PERFORMANCE OF WORK.
15.	EXISTING CONDUIT AND WIRING MAY NEED MODIFICATION TO CLEAR NEW UTILITIES, THE GENERAL CONTRACTOR SHALL COORDINATE WITH ALL TRADES PRIOR TO START OF WORK.
16.	ELECTRICAL CONTRACTOR TO PROVIDE CONTROL WIRING AND ELECTRICAL SERVICE FOR REMOTE REFRIGERATION SYSTEMS FOR WALK-IN BOXES AND COORDINATE LOCATION OF SERVICE WITH ELECTRICAL ENGINEER.
17.	ELECTRICAL CONTRACTOR TO PROVIDE ALL REQUIRED FIELD CONNECTIONS AND INTER-WIRING AT ALL WALK-IN COOLERS AND FREEZERS TO SWITCHES AND CONTROLS FOR LIGHTS, TEMPERATURE ALARMS, DOOR HEATERS AND PRESSURE RELIEF VALVE.
18.	ELECTRICAL CONTRACTOR TO PROVIDE AND INSTALL WRAP AROUND HEAT TAPE ON ALL EVAPORATOR COIL DRAIN LINES IN WALK-IN FREEZERS.
19.	GENERAL CONTRACTOR SHALL BE RESPONSIBLE FOR ALL FEES, PERMITS AND LICENSES FOR THE COMPLETE INSTALLATION OF HIS WORK.
20.	GENERAL CONTRACTOR IS RESPONSIBLE FOR COMPLIANCE WITH ALL LOCAL AND NATIONAL CODES.
21.	GENERAL CONTRACTOR SHALL ALSO PROVIDE CONTROL WIRING, STARTER, SHUNT AND ALL REQUIRED COMPONENTS THAT WILL CONNECT THE CONDENSATE REMOVAL FAN TO THE ON/OFF SWITCH OF THE DISMACHINE. THIS WILL CAUSE THE DISMACHINE OPERATION TO DIRECTLY CONTROL THE OPERATION OF THE CONDENSATE REMOVAL FAN.
NOTE TO ARCHITECT ADD ADDITIONAL CONVENIENCE RECEPTACLES WHERE REQUIRED.	

- NOT FOR CONSTRUCTION -	
THIS DRAWING IS AN INSTRUMENT OF SERVICE ONLY FOR THE LICENSED ARCHITECT AND/OR ENGINEER ON THIS PROJECT.	
PURSUANT TO FLORIDA STATUTE 481.229 SECTIONS BA, BB AND BC THESE DESIGNS, SPECIFICATIONS AND/OR LAYOUTS CANNOT BE USED FOR CONSTRUCTION AND/OR INSTALLATION OF EQUIPMENT UNLESS REVIEWED AND APPROVED BY A LICENSED ARCHITECT OR ENGINEER.	
THESE DRAWINGS ARE PRELIMINARY AND CONCEPTUAL IN NATURE THEY ARE PROVIDED FOR GENERAL INFORMATION PURPOSES ONLY. ANYONE MAKING USE OF THESE DRAWINGS DOES SO AT THEIR OWN RISK AND ASSUMES ALL LIABILITY FOR SUBSEQUENT USE.	







FOODSERVICE ELECTRICAL PLAN

DESIGN DEVELOPMENT
KITCHEN DESIGN
CBI-22158
PALM BEACH COUNTY, FLORIDA

Cheney Brothers
EQUIPMENT & DESIGN DIVISION
3549 S. US HWY 1, SUITE 304
PALM BEACH, FLORIDA 33480
TEL: 561-837-4447 FAX: 561-837-4433
www.cheneybrothers.com

REVISIONS AND MODIFICATIONS	
NO.	DESCRIPTION
1	DESIGN APPROVAL
2	DESIGN APPROVAL
3	DESIGN APPROVAL
SCALE: 1/4"=1'-0"

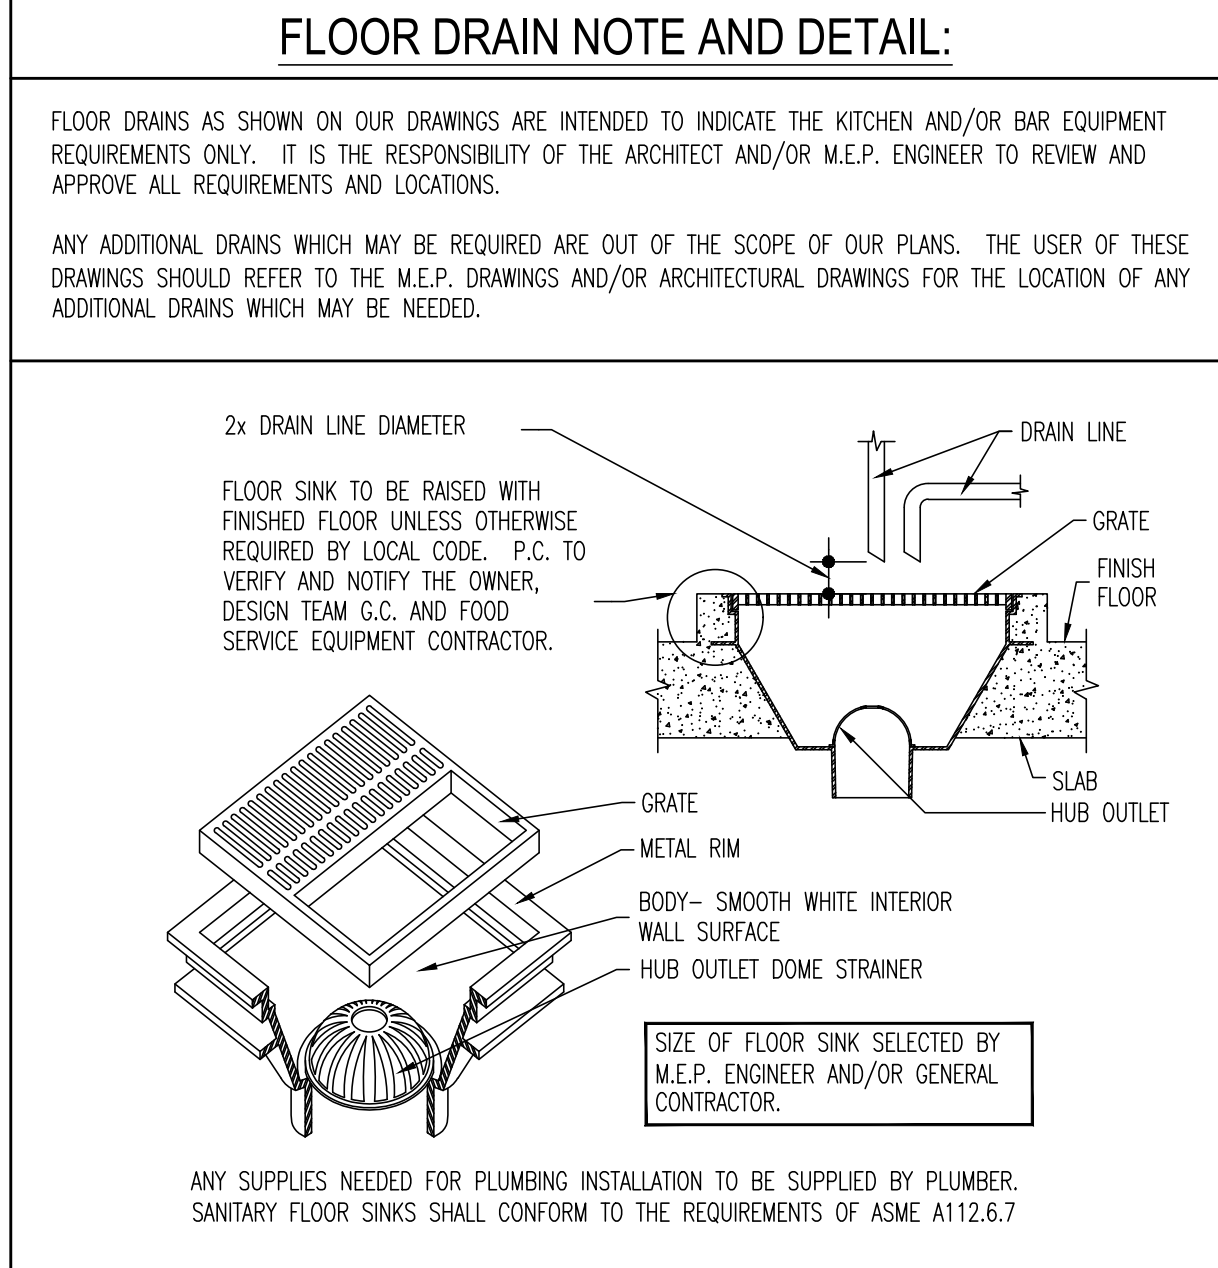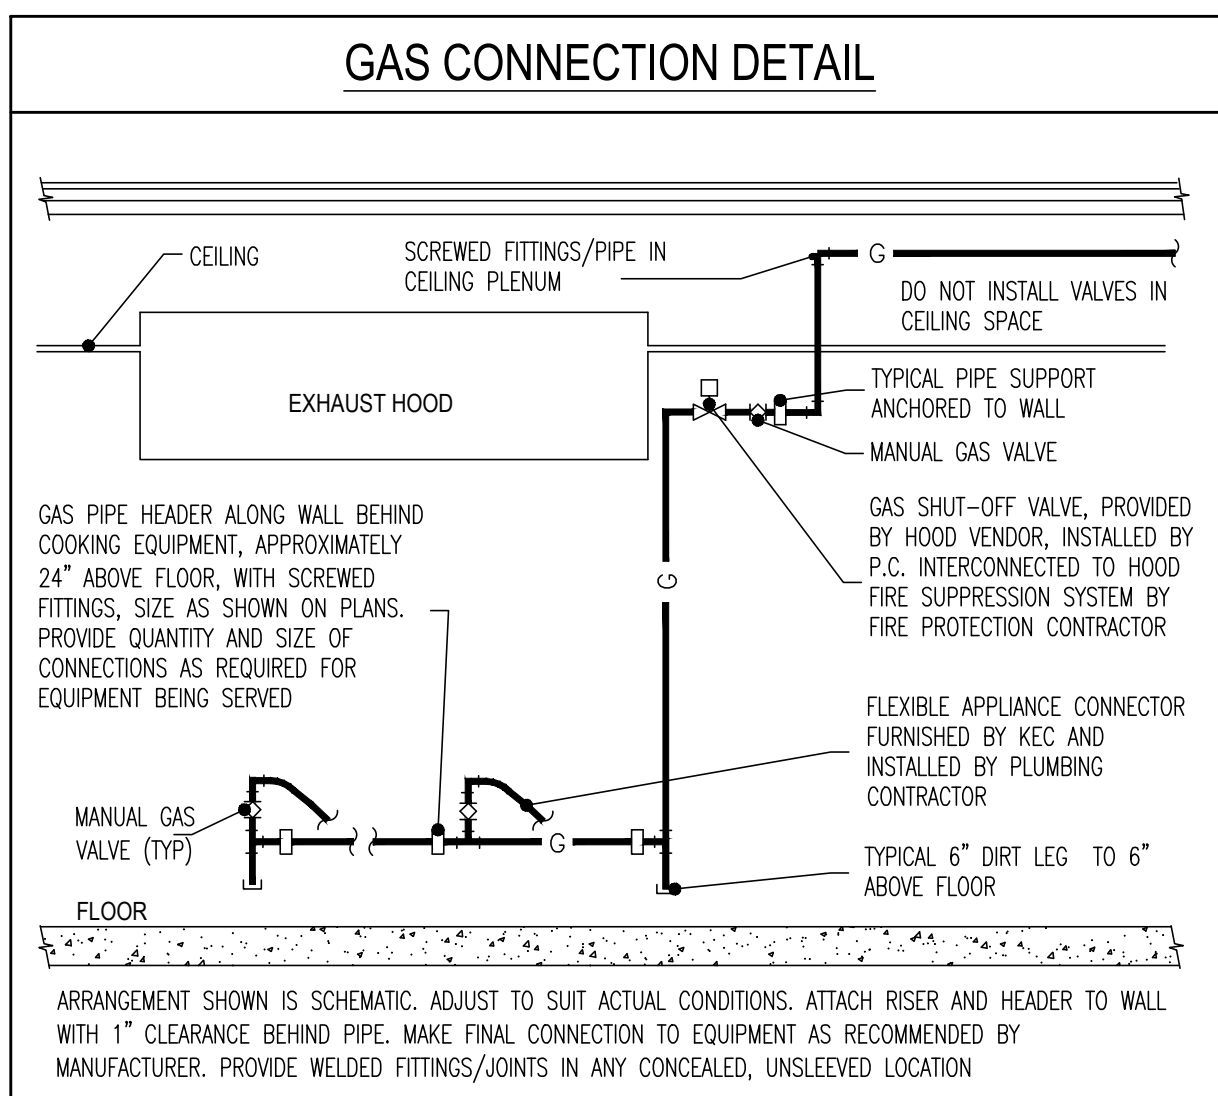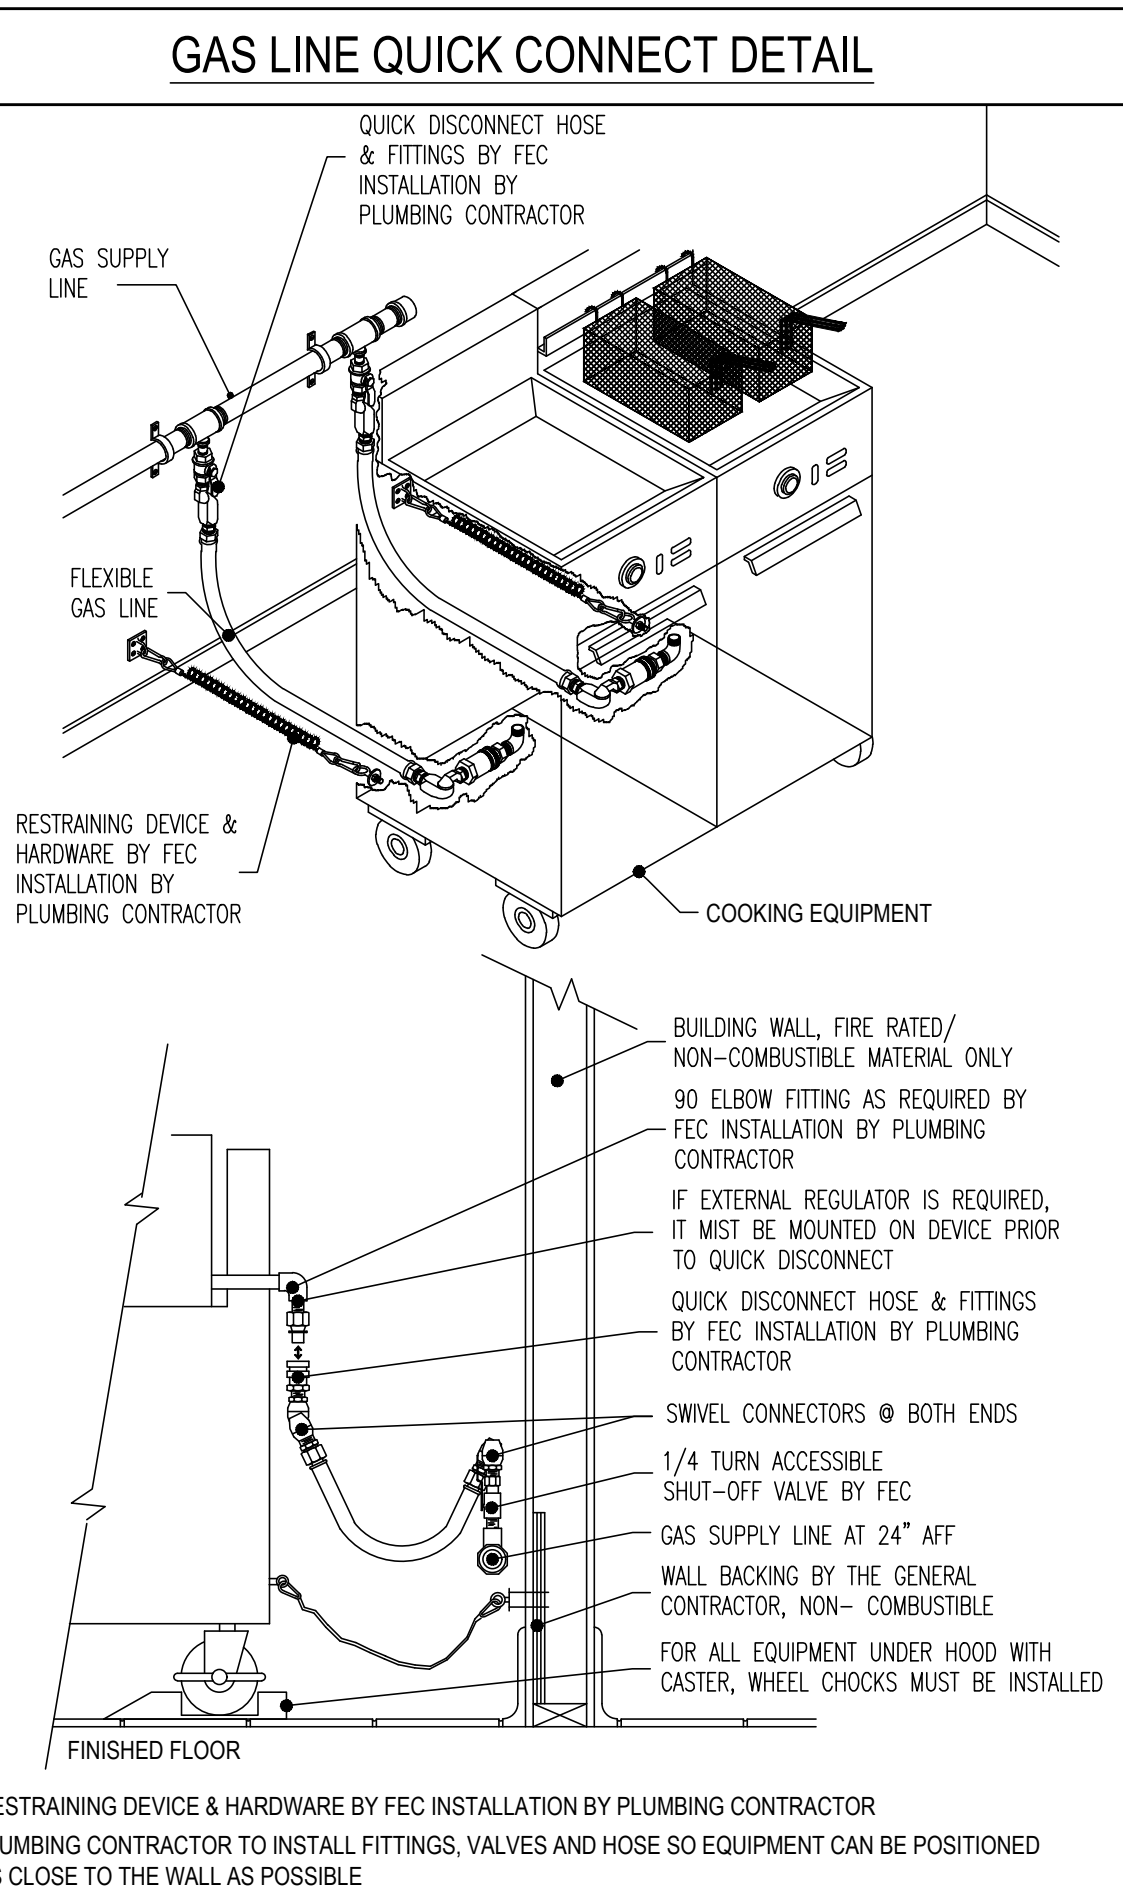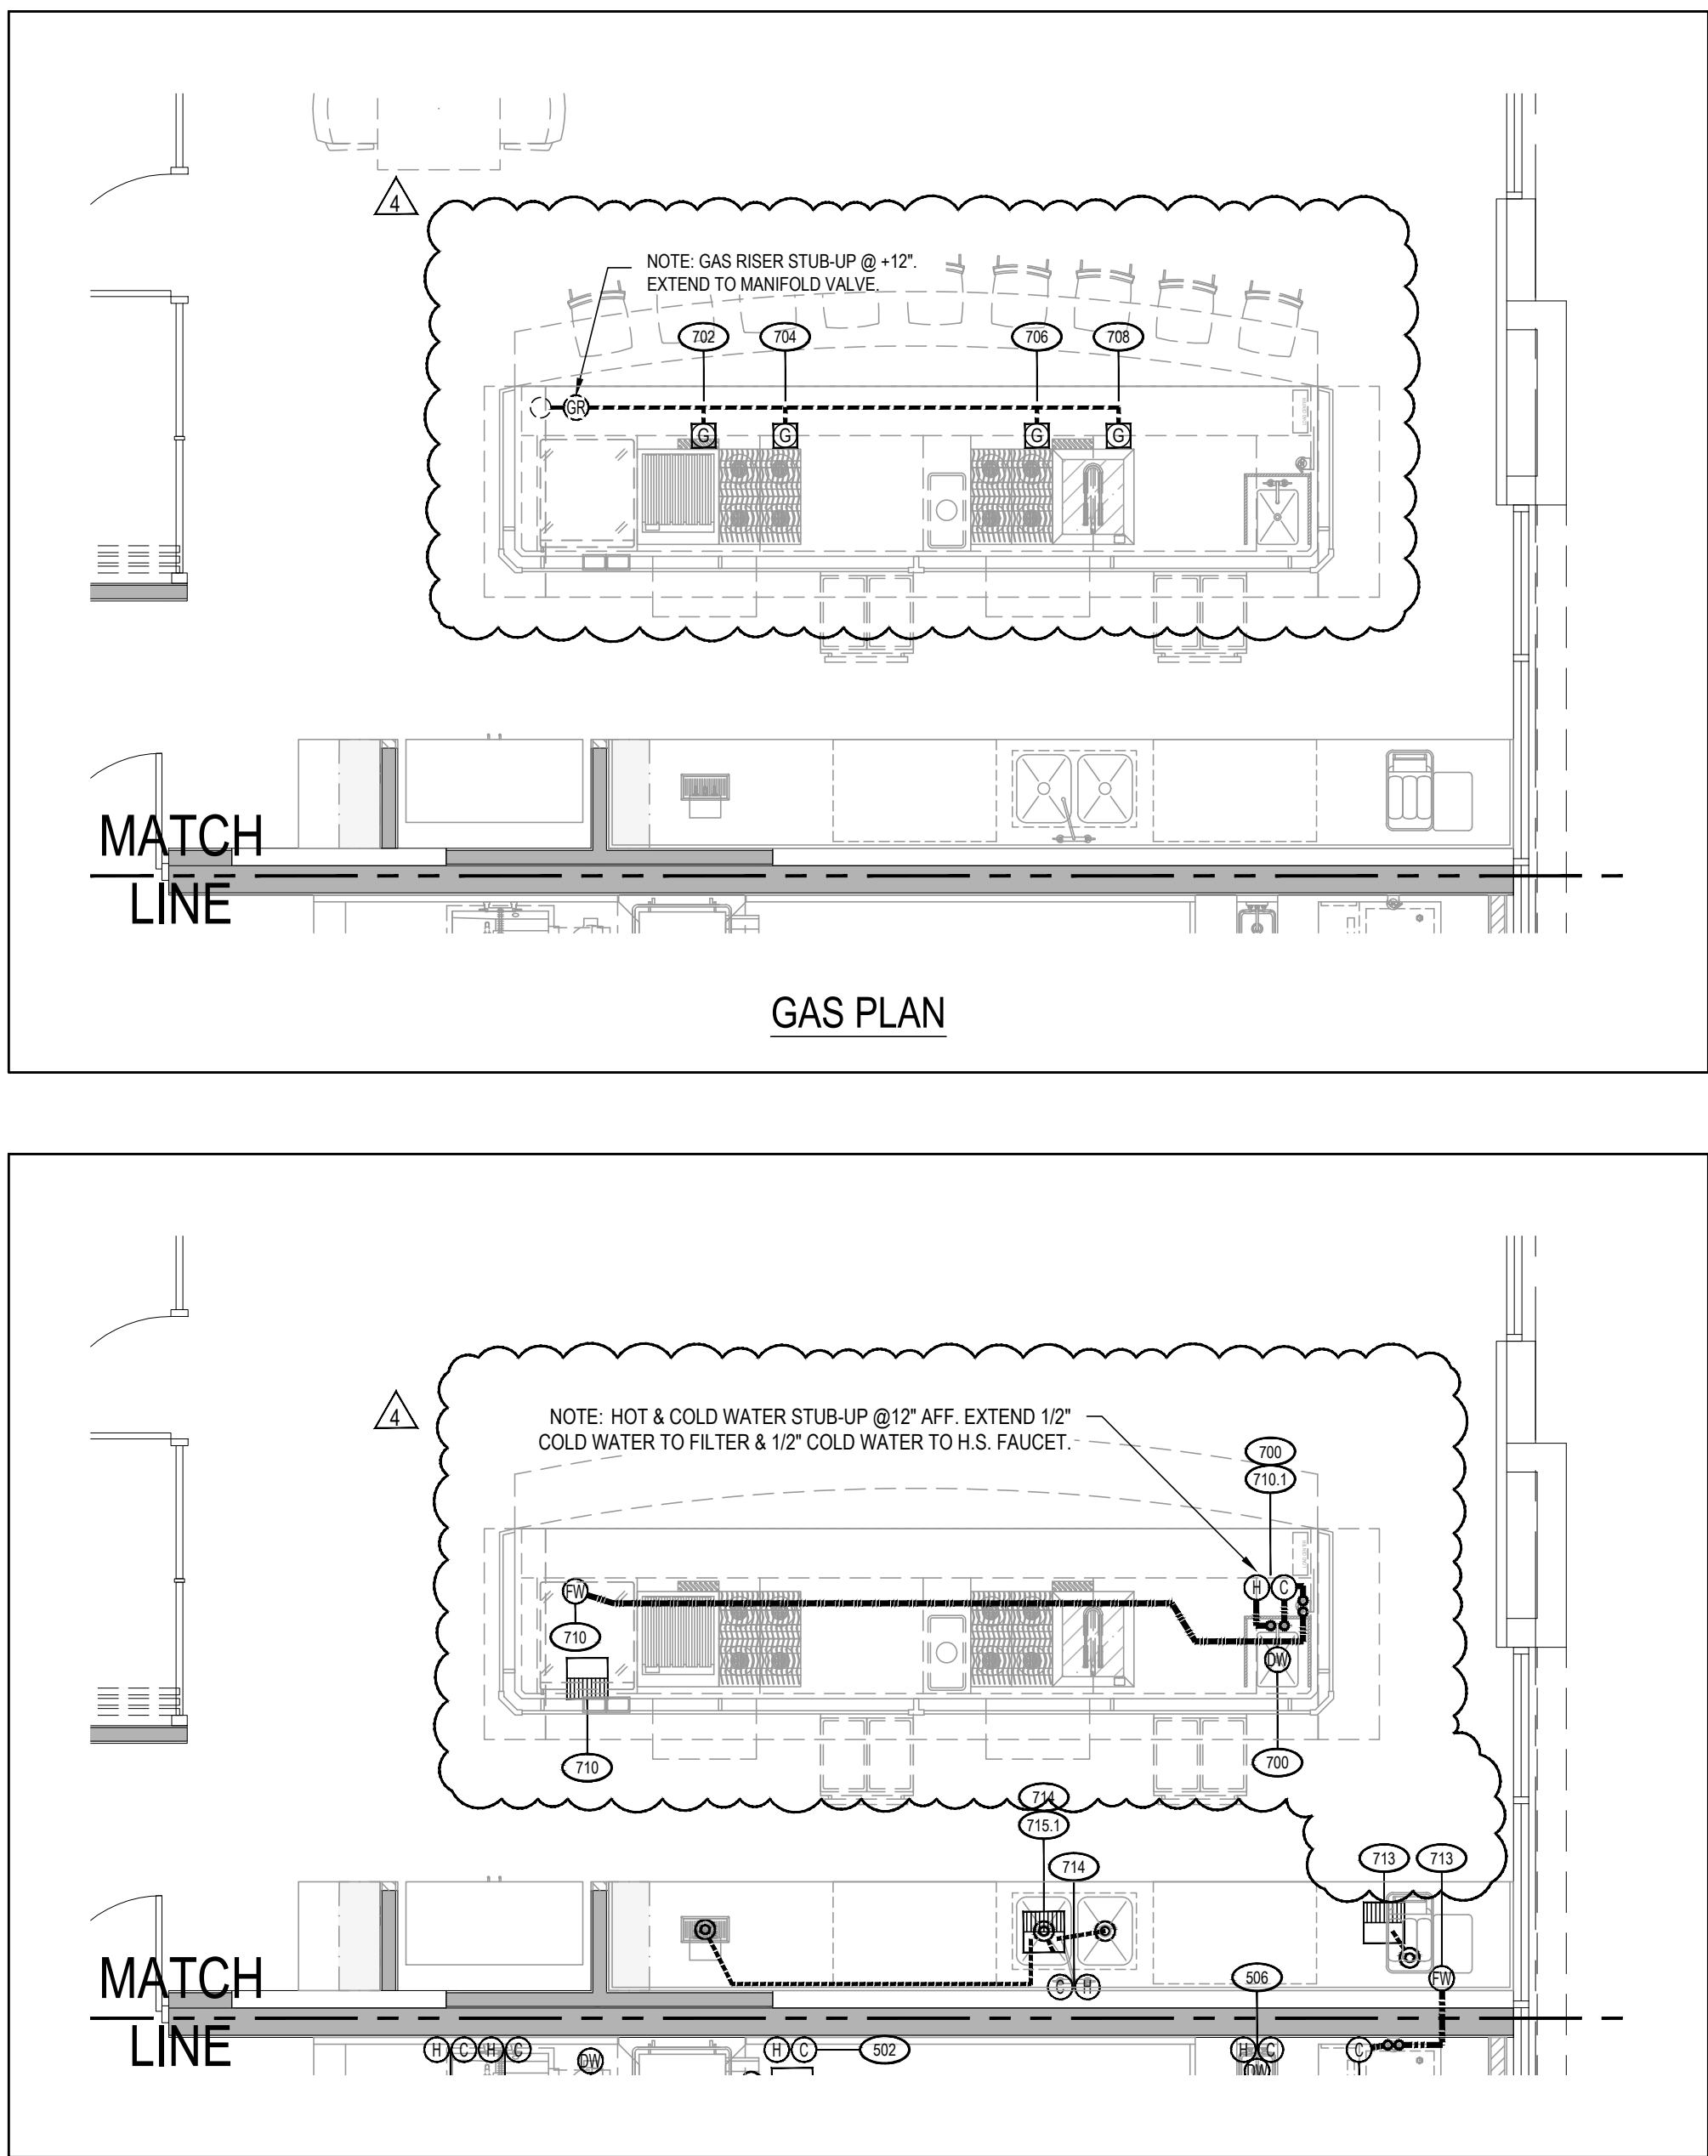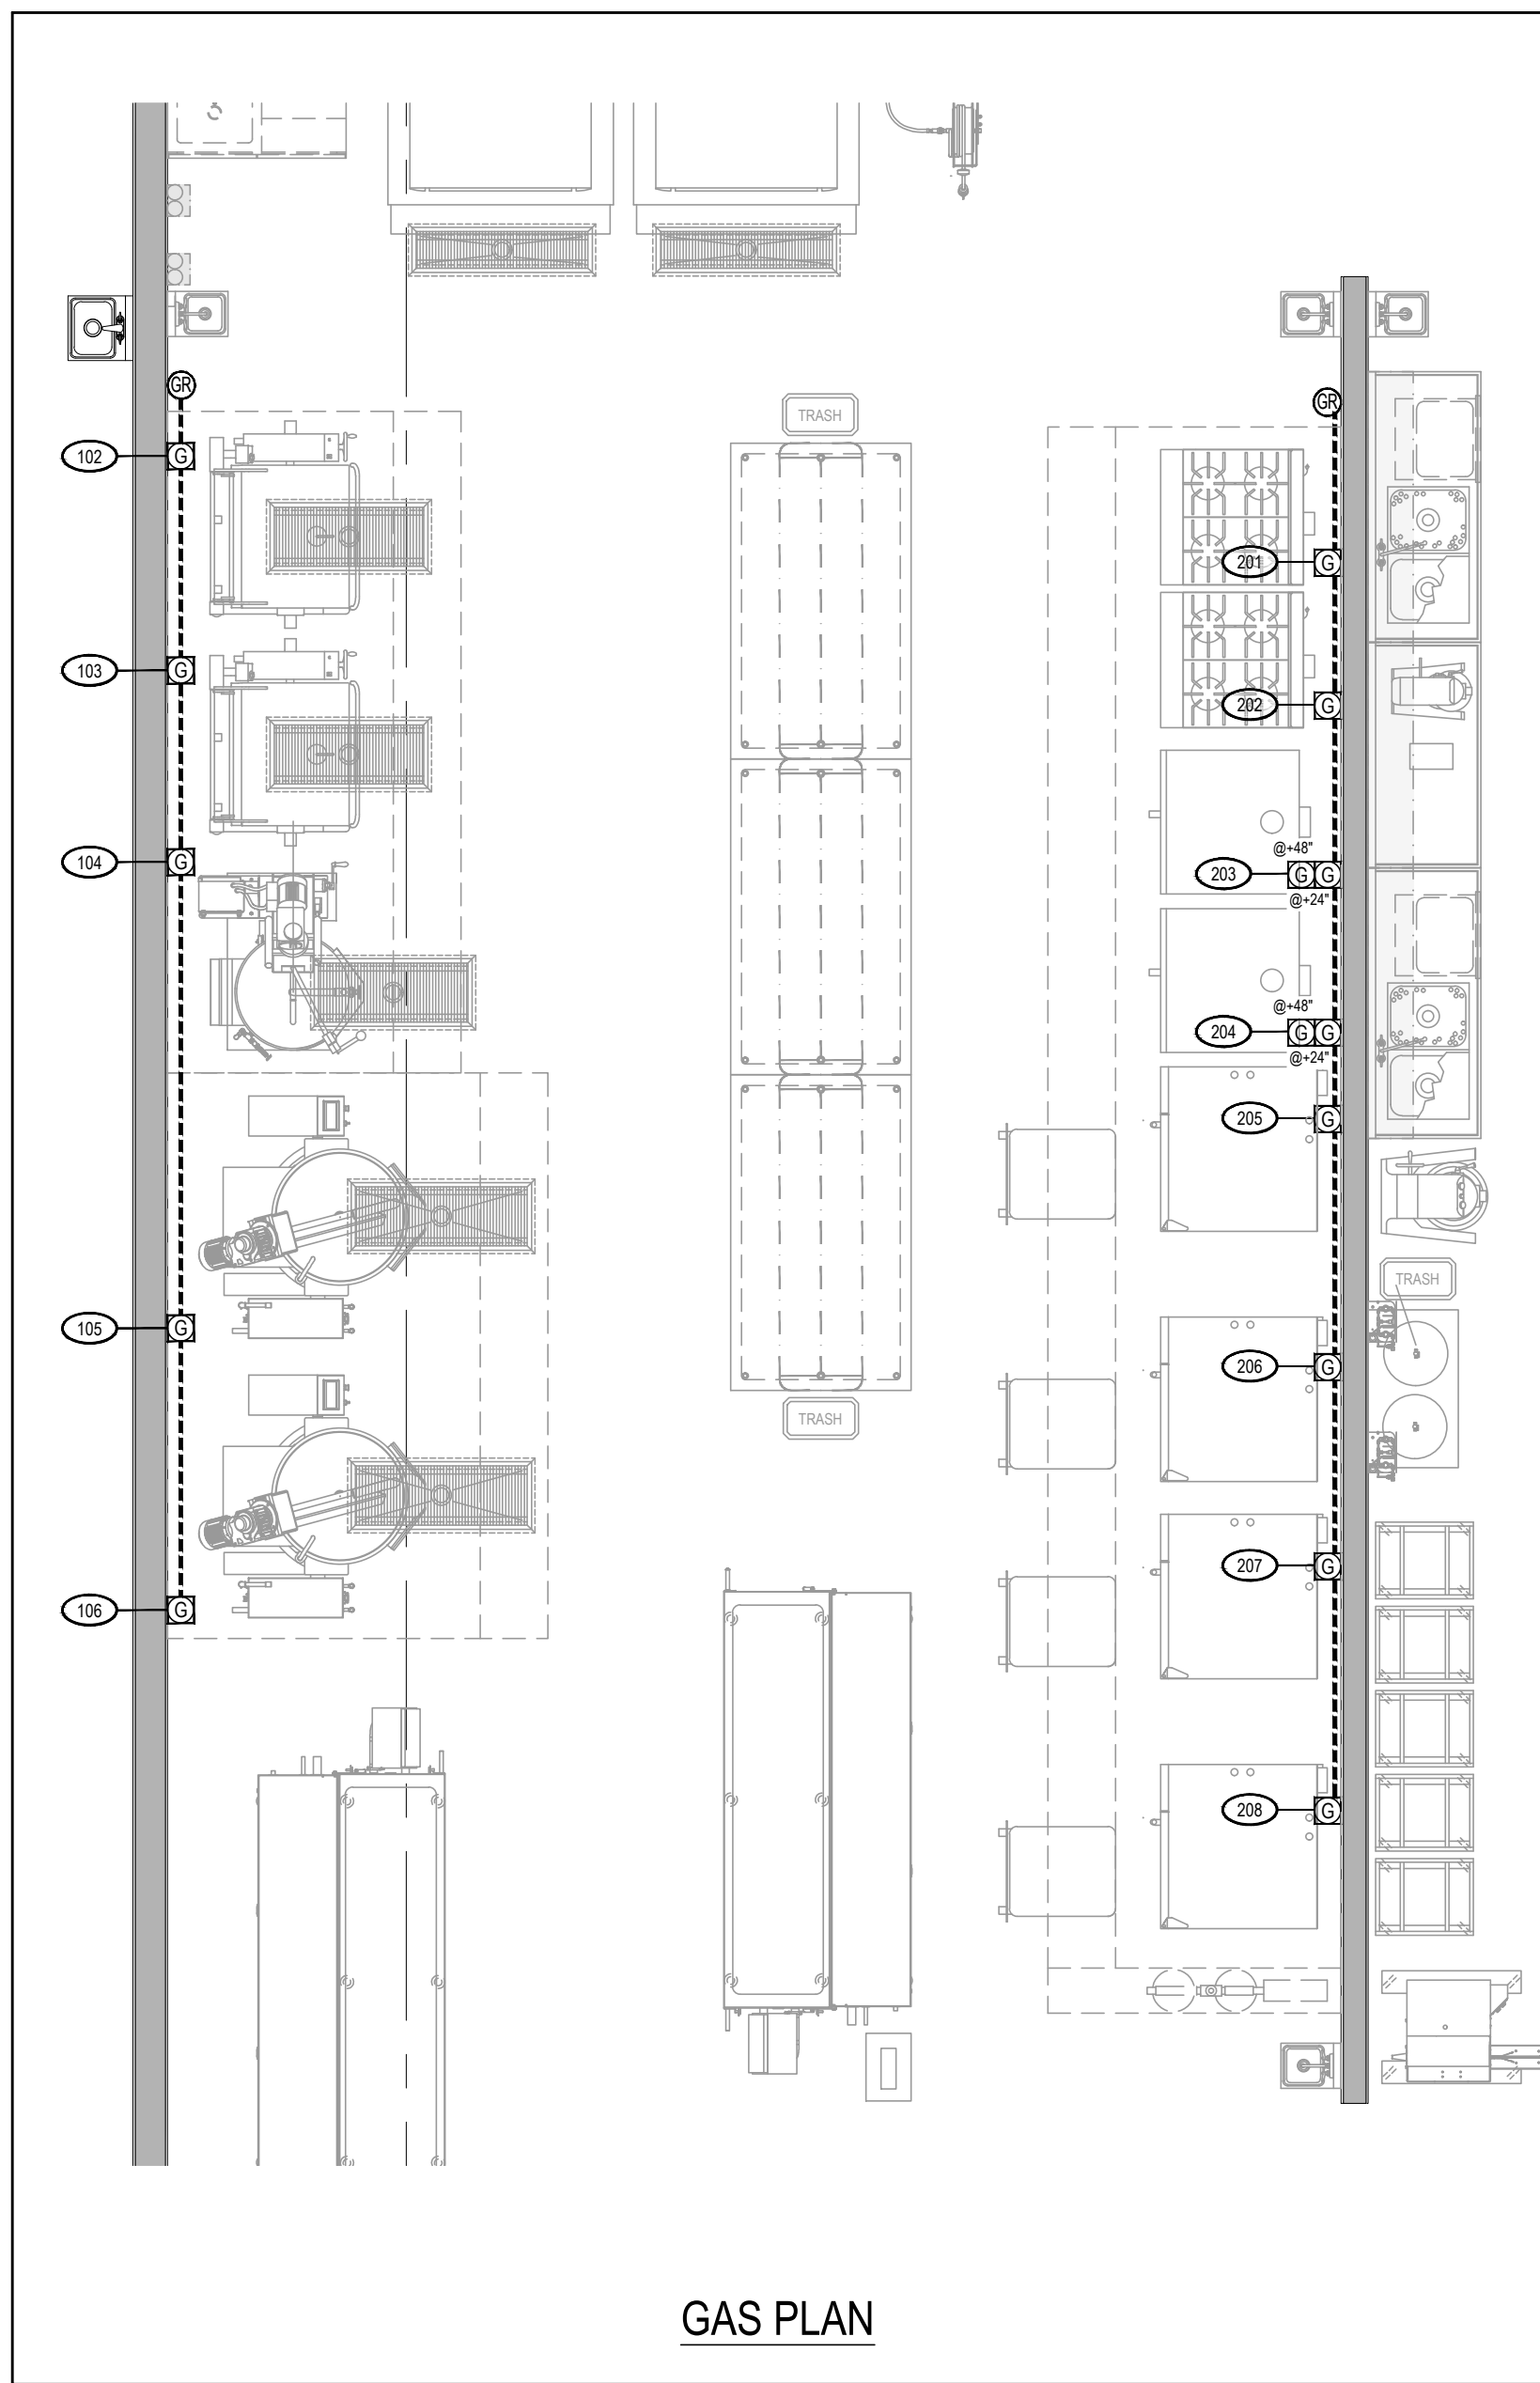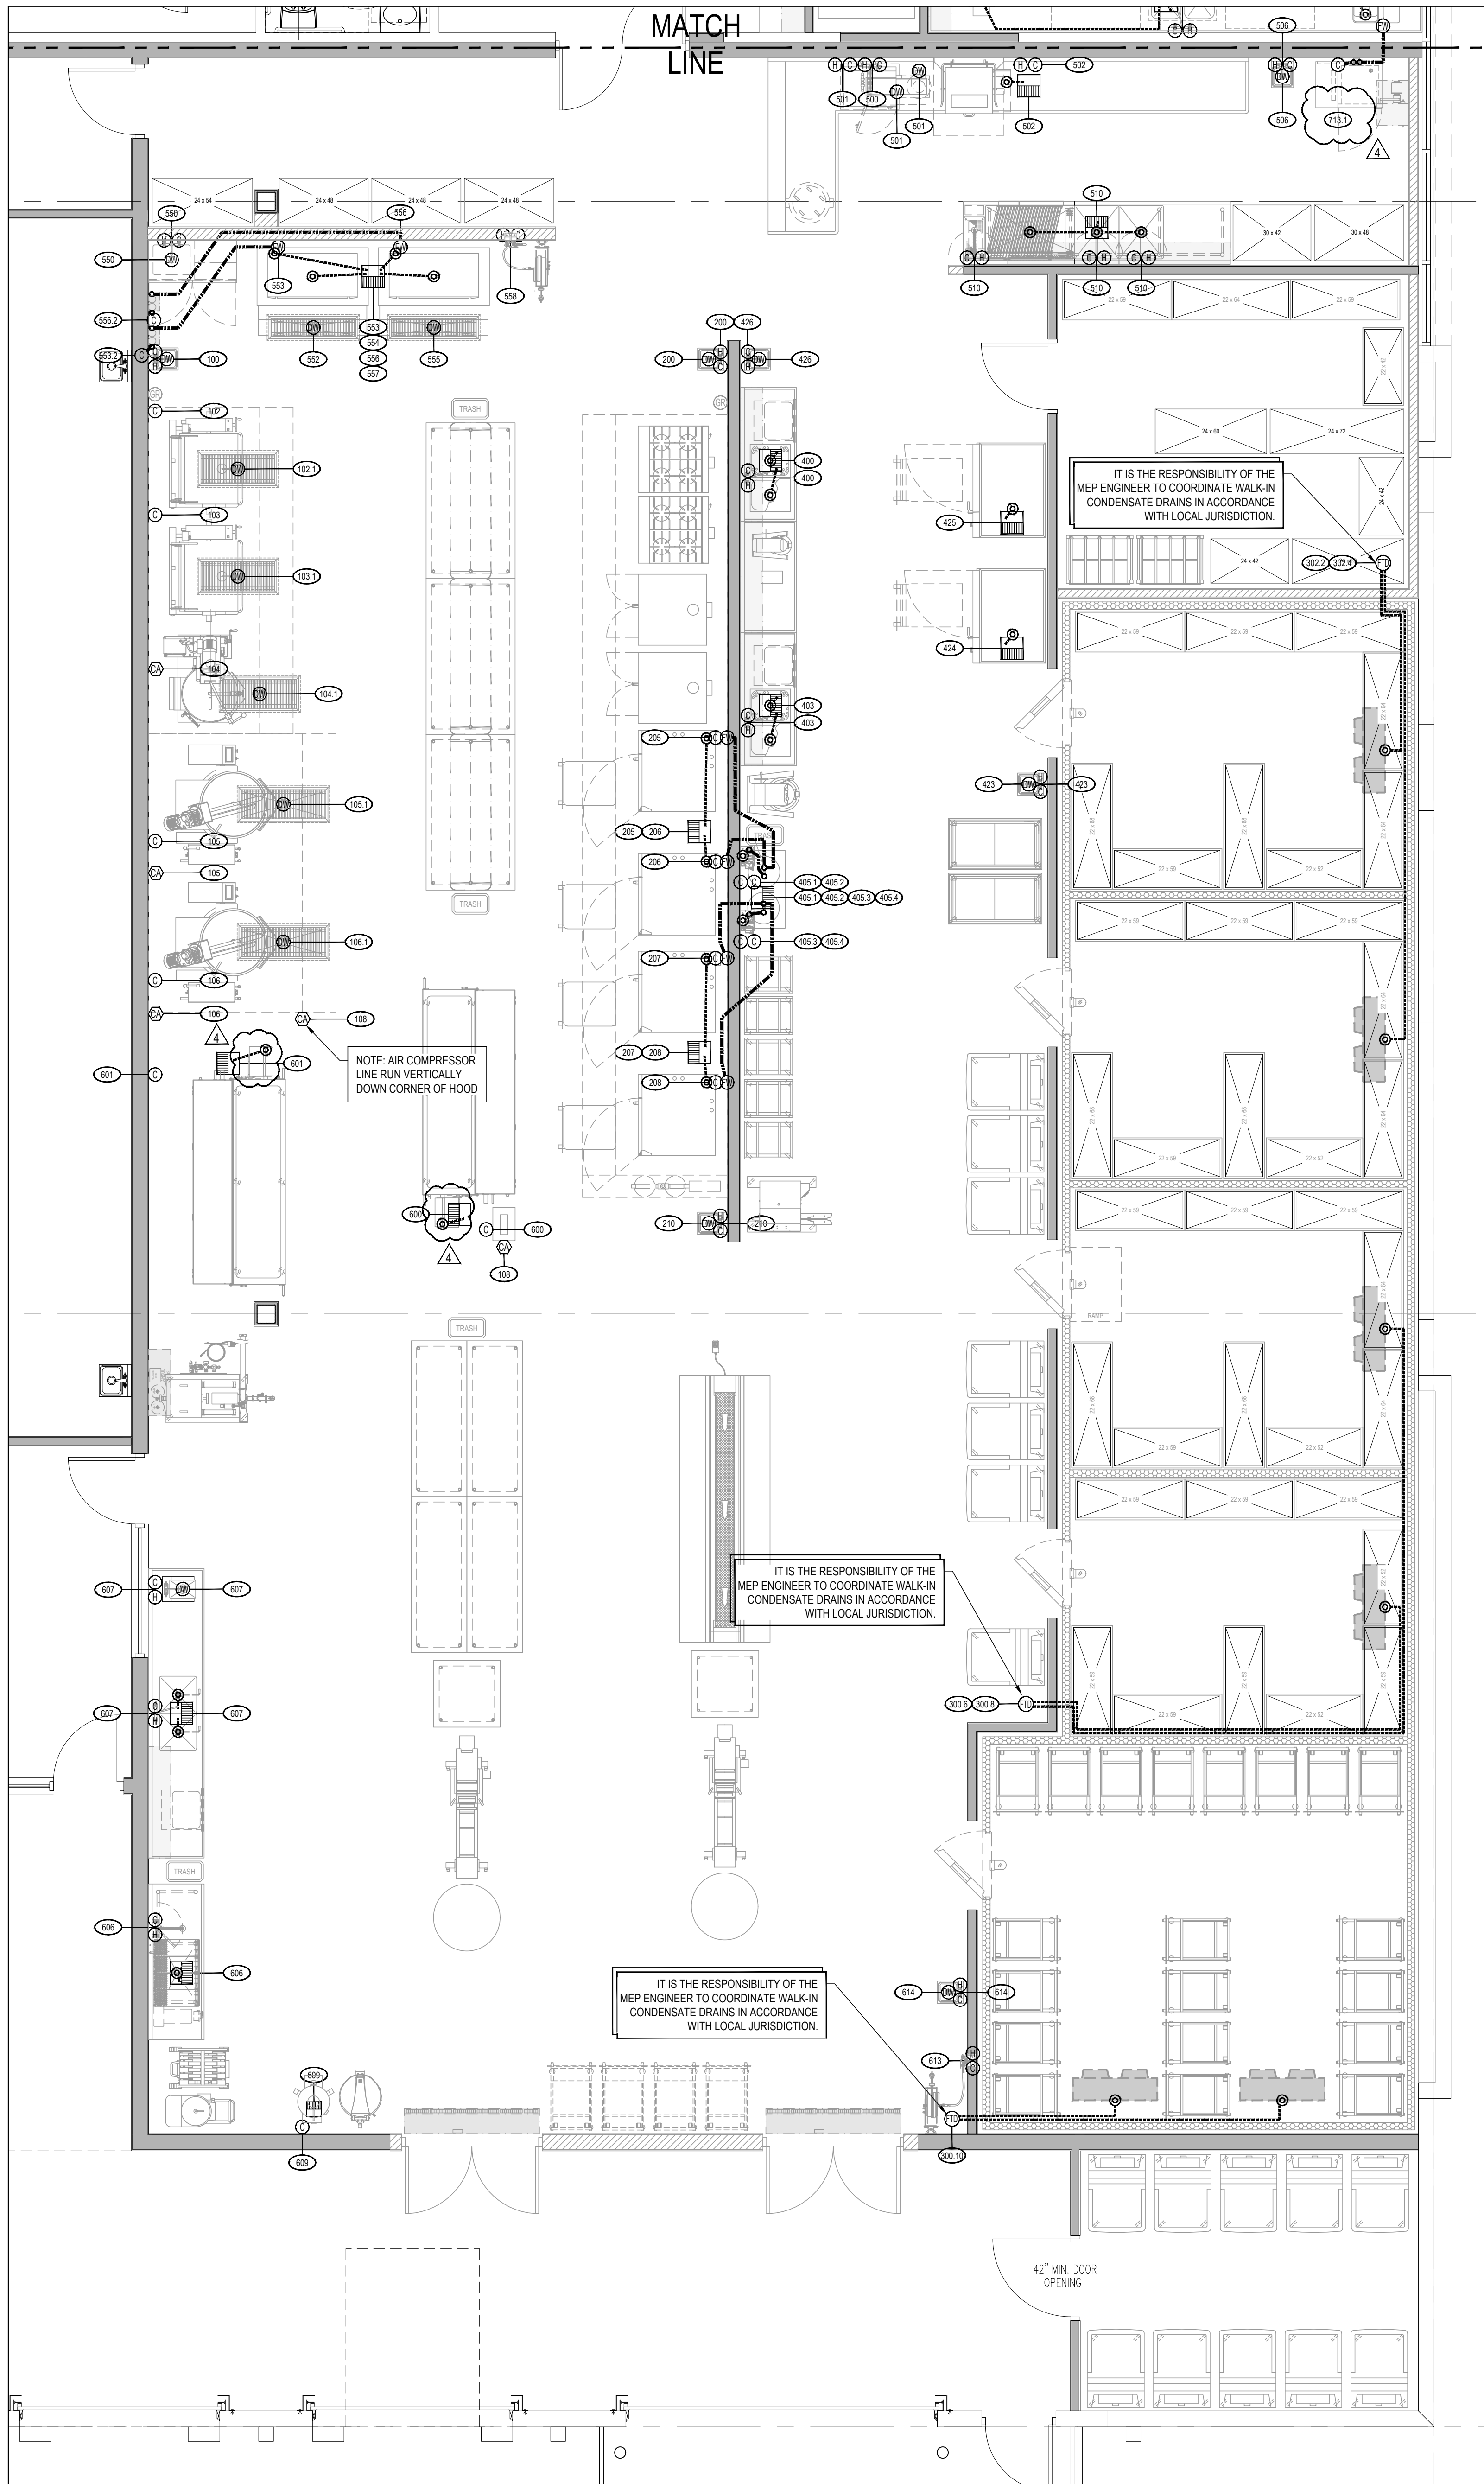

- ### PLUMBING NOTES
- THESE DRAWINGS ARE NOT TO BE USED FOR CONSTRUCTION. THESE DRAWING SHOWS PLUMBING REQUIREMENTS FOR THE FOOD SERVICE EQUIPMENT ONLY. THIS DRAWING IS INTENDED TO COMPLEMENT THE ARCHITECTURAL AND ENGINEERING CONSTRUCTION DOCUMENTS FOR THIS PROJECT AND MUST BE USED AND COORDINATED WITH THOSE DRAWINGS AND SPECIFICATIONS.
 - THESE DRAWINGS ARE INTENDED TO COMPLEMENT THE EQUIPMENT MFR'S CATALOG SHEETS AND SHOP DRAWINGS AND MUST BE USED IN COORDINATION WITH THOSE DRAWINGS AND SPECIFICATIONS.
 - ALL PLUMBING WORK MUST BE PERFORMED AND COMPLY TO ALL PREVAILING HEALTH AND BUILDING CODES. NOTIFY THE PROJECT ARCHITECT IF ANY INFORMATION CONTAINED IN THESE DRAWINGS DOES NOT CONFORM TO ANY CODE ENFORCED.
 - THESE DRAWINGS HAVE BEEN PREPARED FROM THE ARCHITECTURAL DRAWINGS. ANY DISCREPANCIES BETWEEN THESE DRAWINGS AND ACTUAL FIELD CONDITIONS MUST BE ANNOUNCED IMMEDIATELY.
 - ALL DIMENSIONS SHOWN ARE TO BE MEASURED FROM FINISHED SURFACES. ALL WRITTEN DIMENSIONS SUPERSEDE SCALE. ALL DIMENSIONS ARE TO CENTERS OF ROUGH-INS. DO NOT SCALE DRAWINGS.
 - THE FOOD SERVICE EQUIPMENT WILL BE PROVIDED WITH ONLY THE DEVICES SUPPLIED AS STANDARD BY THE MFR. OR AS SPECIFIED BY THE CONSULTANT. THE PC SHALL PROVIDE AND INSTALL ALL OTHER NECESSARY CONTROLS, VALVES, REGULATORS, TRIM, TRAPS, TAILPIECES, STRAINERS, BACK-FLOW PREVENTION, AND ANY OTHER MATERIALS REQUIRED FOR A PROPER INSTALLATION. THE PC SHALL COORDINATE AND MAKE ALLOWANCES FOR THESE DEVICES.
 - THE PC SHALL INSTALL AND INTERCONNECT ALL PLUMBING COMPONENTS, ACCESSORIES AND SYSTEMS REQUIRED TO MAKE A COMPLETE AND PROPER INSTALLATION. ALL PLUMBING LINES SHALL BE RUN CONCEALED WHEREVER POSSIBLE.
 - THE PC SHALL VERIFY WATER PRESSURE REQUIREMENTS FOR EACH EQUIPMENT ITEM IN THESE PLANS AND TO PROVIDE CONTROL DEVICES TO INSURE PROPER WATER PRESSURE AS SPECIFIED BY THE MFR.
 - THE PC SHALL VERIFY ALL REQUIREMENTS FOR ITEMS LISTED AS: EXISTING, BY OWNER, BY VENDOR, N/C OR BY OTHERS.
 - THE PC SHALL PROVIDE AND INSTALL ALL GREASE INTERCEPTORS, FLOOR DRAINS AND FLOOR SINKS. LOCATIONS OF THESE ITEMS MUST BE COORDINATED WITH THE PSEC.
 - FLOOR DRAINS SHOWN ON THESE DRAWINGS ARE FOR THE FOOD SERVICE EQUIPMENT ONLY. THE PC MUST VERIFY LOCATIONS FOR ALL OTHER FLOOR DRAINS THAT MAY BE REQUIRED.
 - THE PC SHALL COORDINATE THE LOCATION OF AND INSTALL THE GAS SHUT-OFF VALVE, FURNISHED BY THE PSEC.

PLUMBING LEGEND			
(H)	HOT WATER SUPPLY TO EQUIPMENT	(H)	DRAIN LOCATION ON EQUIPMENT
(C)	COLD WATER SUPPLY TO EQUIPMENT	(H)	WASTE, DIRECT-CONNECTED UNLESS NOTED "OPEN HUB"
(F)	FILTERED COLD WATER	(H)	FLOOR SINK HALF GRATE DOME STRAINER
(S)	GAS SERVICE LOCATION	(H)	FUNNEL TYPE FLOOR DRAIN
(A)	COMPRESSED AIR		

- NOT FOR CONSTRUCTION -

THIS DRAWING IS AN INSTRUMENT OF SERVICE ONLY FOR THE LICENSED ARCHITECT AND/OR ENGINEER ON THIS PROJECT.

PURSUANT TO FLORIDA STATUTE 481.229 SECTIONS 8A, 8B AND 8C THESE DESIGNS, SPECIFICATIONS AND/OR LAYOUTS CANNOT BE USED FOR CONSTRUCTION AND/OR INSTALLATION OF EQUIPMENT UNLESS REVIEWED AND APPROVED BY A LICENSED ARCHITECT OR ENGINEER.

THESE DRAWINGS ARE PRELIMINARY AND CONCEPTUAL IN NATURE. THEY ARE PROVIDED FOR GENERAL INFORMATION PURPOSES ONLY. ANYONE MAKING USE OF THESE DRAWINGS DOES SO AT THEIR OWN RISK AND ASSUMES ALL LIABILITY FOR SUBSEQUENT USE.

FOODSERVICE PLUMBING PLAN

DESIGN DEVELOPMENT
KITCHEN DESIGN

CBI-22158

PALM BEACH COUNTY, FLORIDA

SCALE: 1/4"=1'-0"

REVISIONS AND MODIFICATIONS

NO.	DESCRIPTION	DATE
1	DESIGN APPROVAL	09/06/2022
2	DESIGN APPROVAL	09/06/2022
DESIGNED: 09-06-2022

DRAWN: SC / JV

CHECKED: -

PM: JC

JOB NO.: CBI-22158

SHEET: K1-3.0

CHENEY BROTHERS



EQUIPMENT & DESIGN DIVISION

3500 S. PALM BEACH BLVD., SUITE 300

WEST PALM BEACH, FLORIDA 33411

407-871-2244

www.cheneybros.com

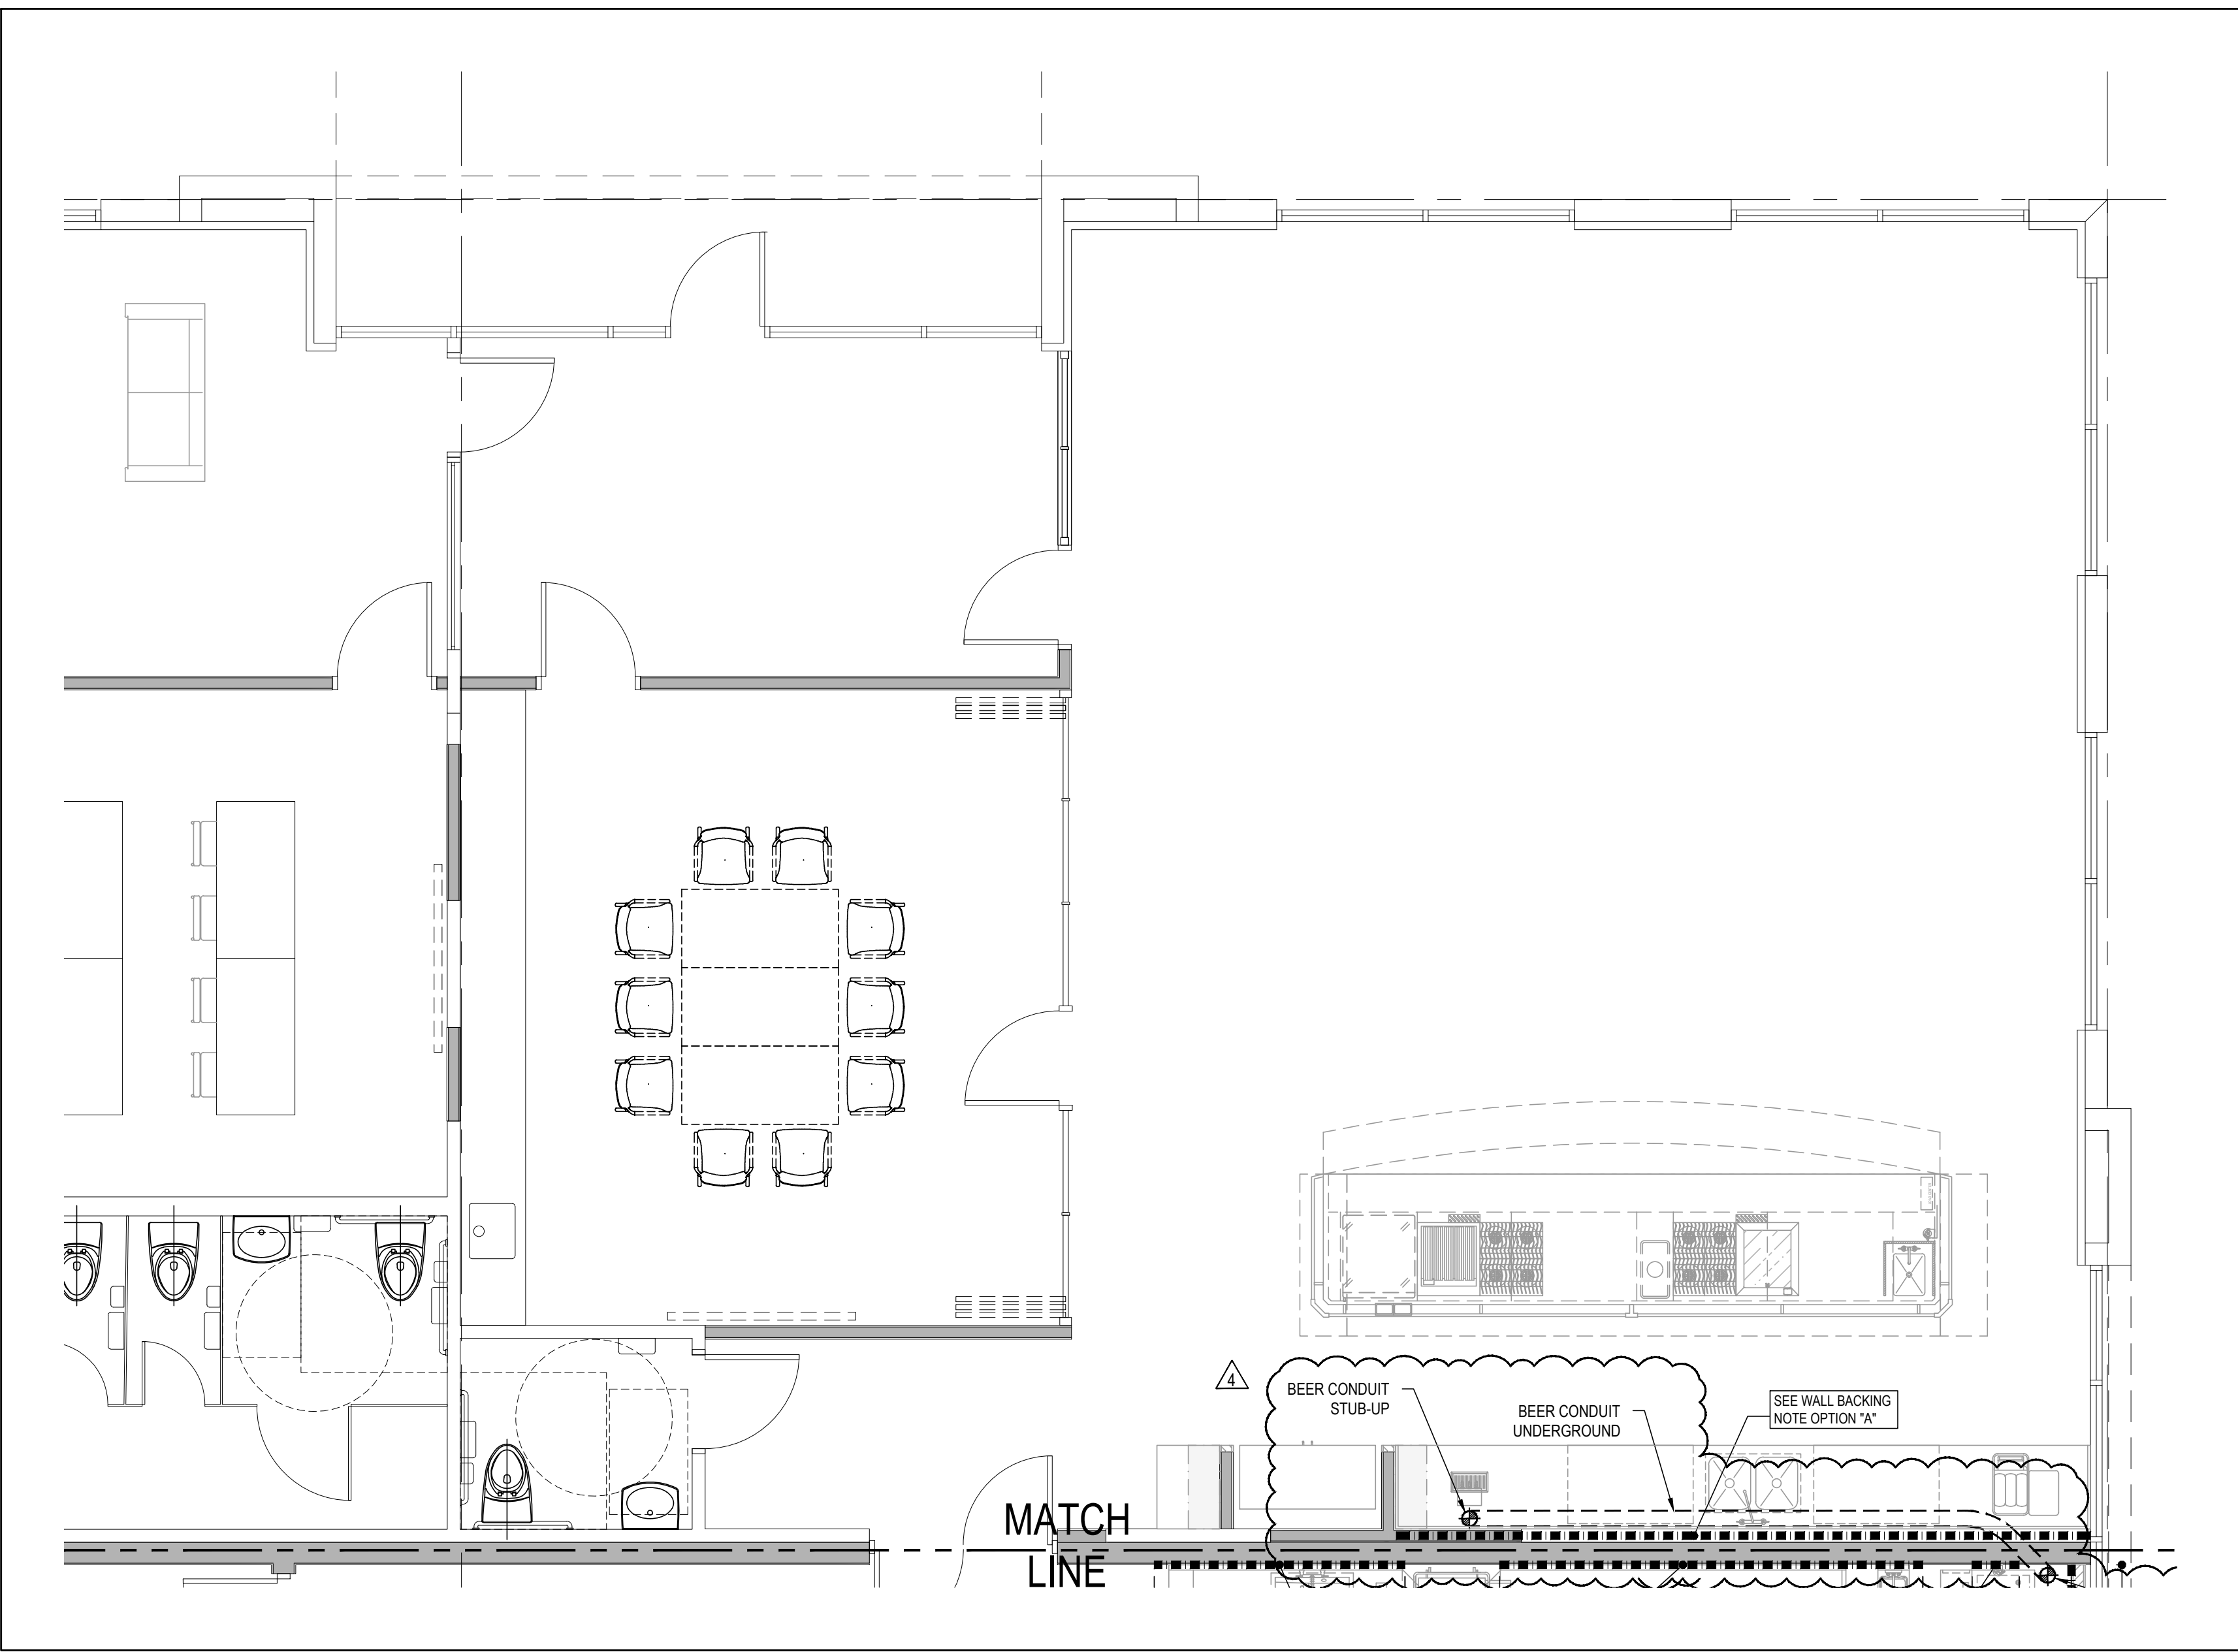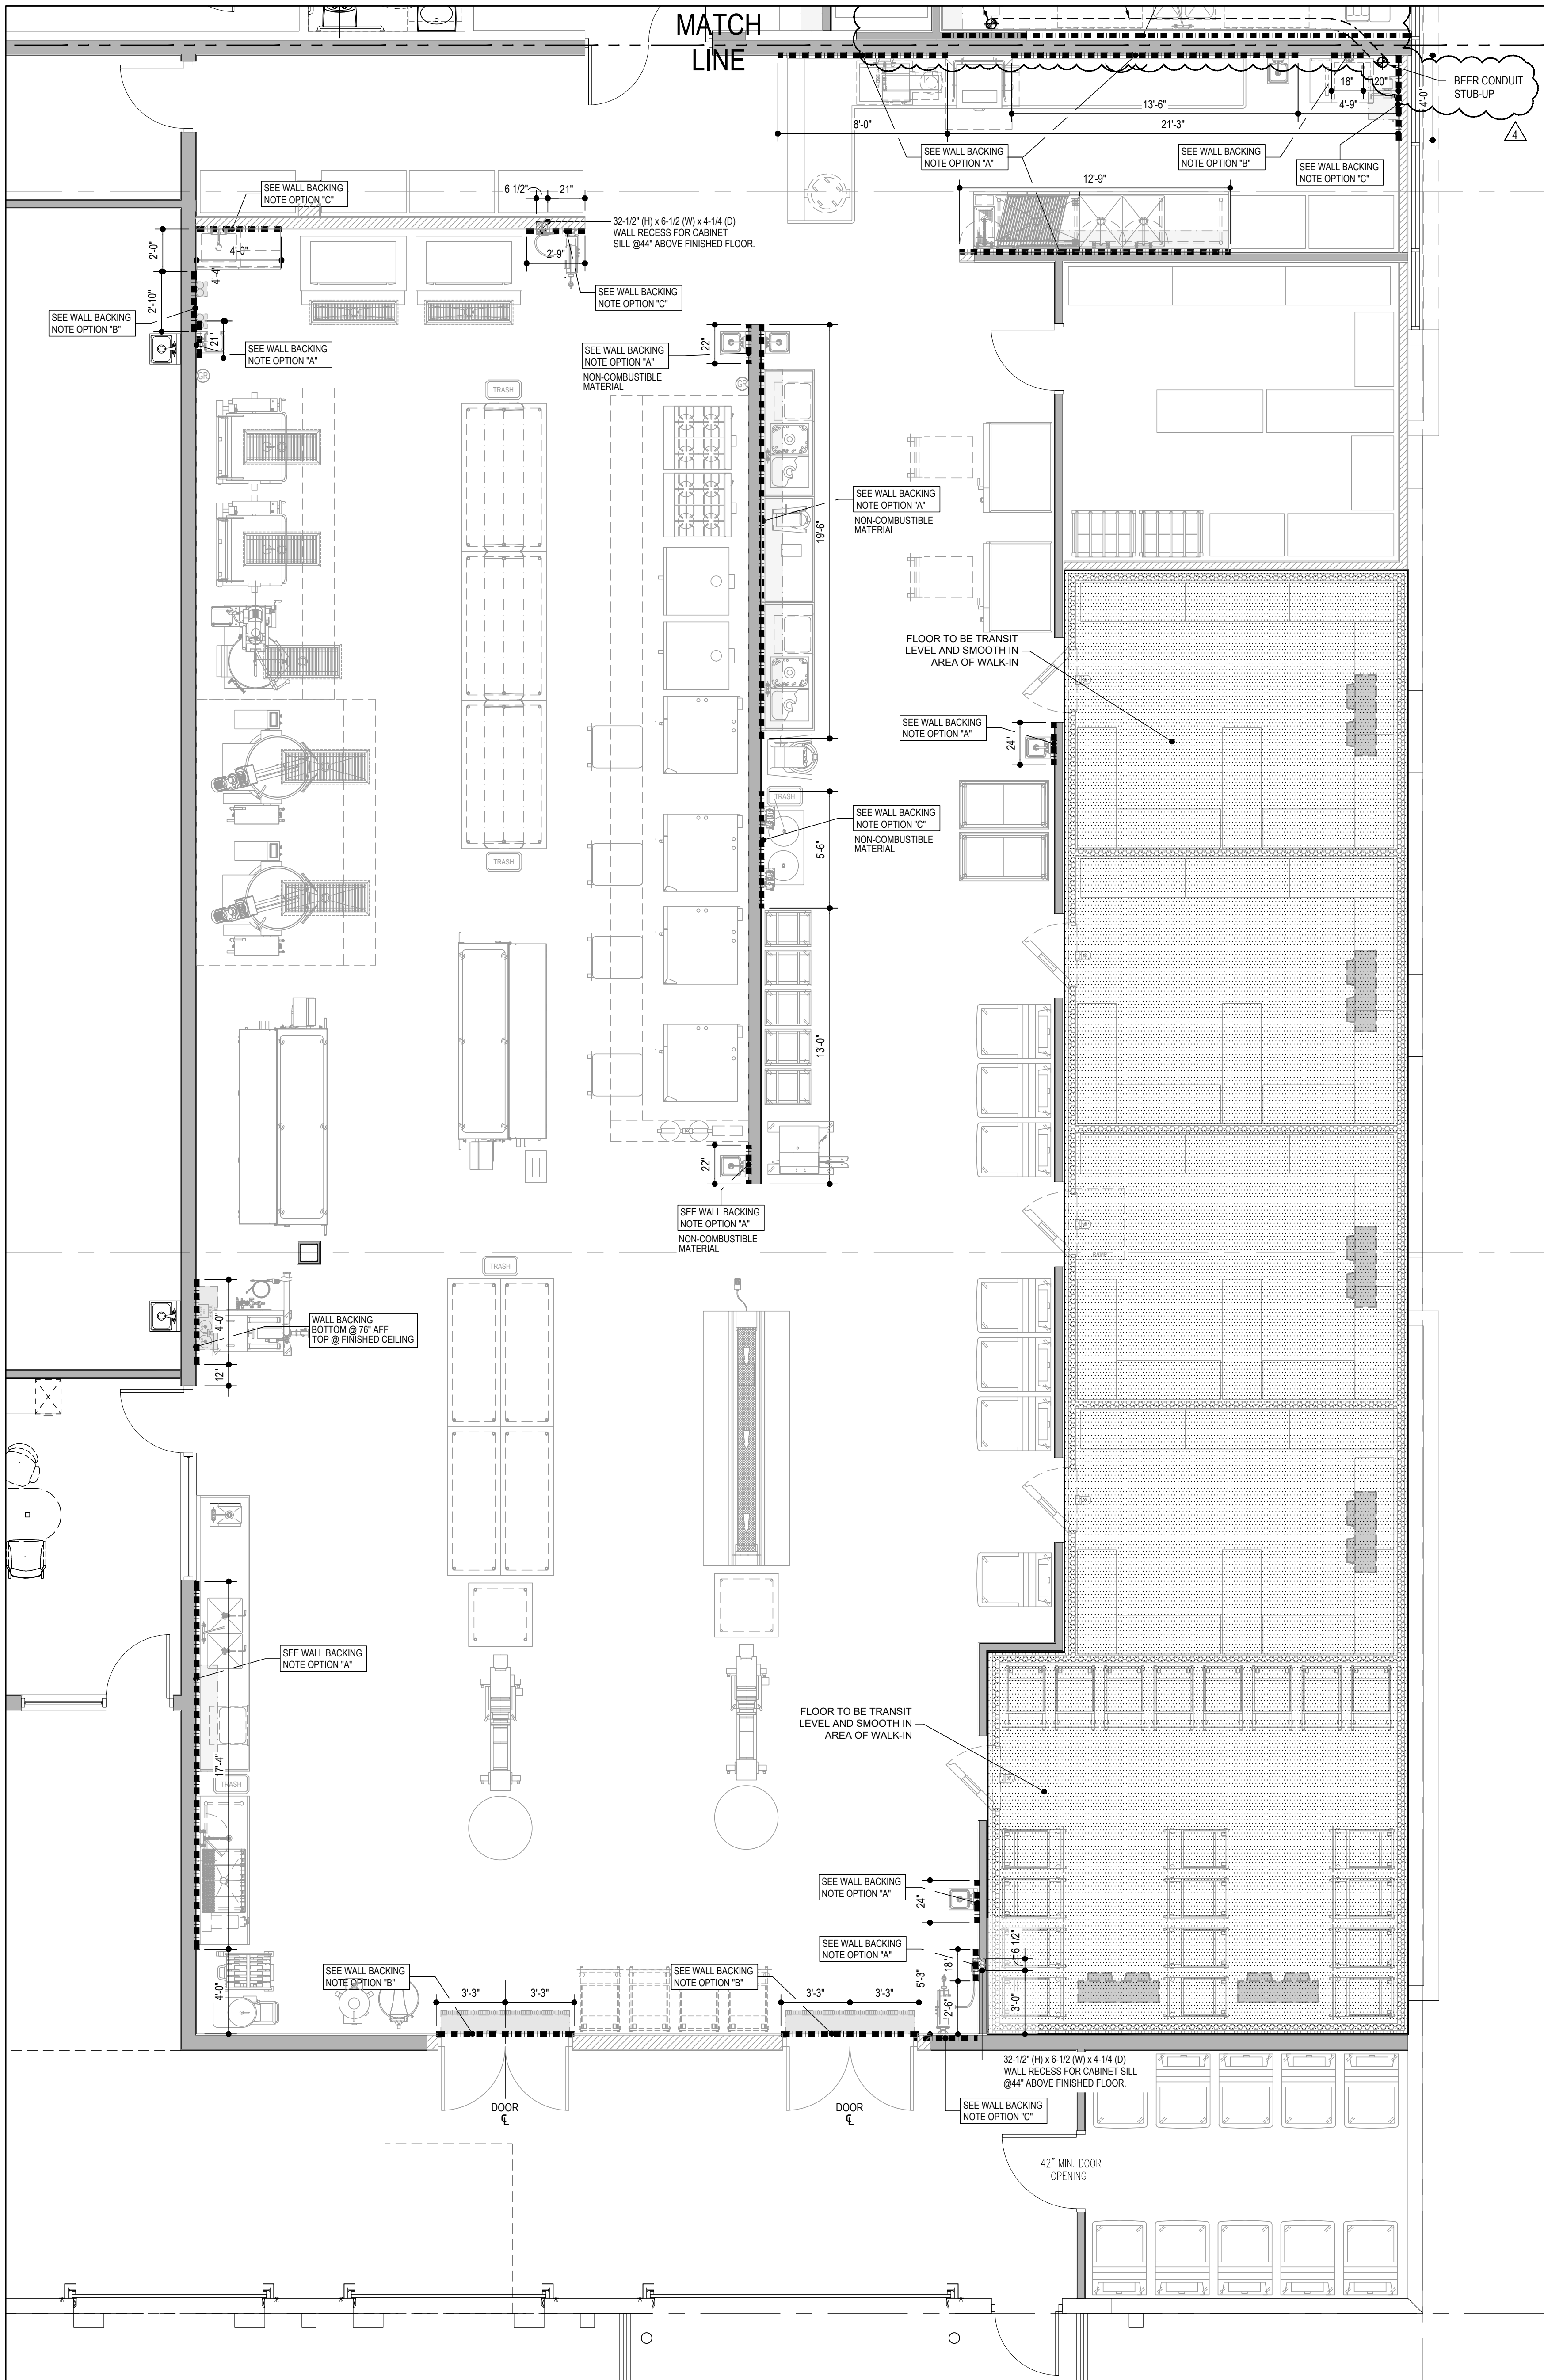

BEVERAGE SYSTEM CONDUIT NOTES AND DETAILS

CONDUIT AND BUILDING PENETRATIONS SHALL BE THE RESPONSIBILITY OF THE BUILDING TRADES AND TO COMPLY WITH ALL LOCAL CODES.

EXACT LINE RUNS SHALL BE DETERMINED IN COORDINATION WITH THE BEVERAGE SYSTEM INSTALLER. LINE RUN SHOWN ON PLAN INDICATES DESIRED CONNECTION AND NOT THE ACTUAL LINE RUN.

PROVIDE P.V.C. CONDUIT, AS INDICATED ON PLAN, THRU SLAB, WALLS OR CEILINGS, WITH 24" RADIUS MINIMUM SWEEPING BENDS, INTERNALLY SMOOTH AND WATERTIGHT.


FURNISH P.V.C. CONDUIT AS DESCRIBED IN ARTICLE 347 OF THE NATIONAL ELECTRIC CODE, STANDARD 651 NEMA SPEC. 7-C2 ROBINTECH P.V.C. DUCT AND SWEEP ELBOWS OR EQUAL. CAUTION: PLUMBING STYLE P.V.C. SHORT RADIUS FACTORY "ELLS" ARE NOT ACCEPTABLE.

A PULL BOX SHALL BE INSTALLED AFTER EVERY TWO RADIUS BENDS OR 75 FEET OF CONDUIT.

ALL JOINTS SHALL BE SOLVENT CEMENTED AS RECOMMENDED BY THE MANUFACTURER AND PRESSURE TESTED FOR LEAKS PRIOR TO BACKFILLING, TO CREATE A LIQUID TIGHT CONDITION.

1-9 BEVERAGE LINES: 8" CONDUIT LINE WITH 24" MINIMUM RADIUS SWEEP BENDS (MAX 3)
10-12 BEVERAGE LINES: 8" CONDUIT LINE WITH 30" MINIMUM RADIUS SWEEP BENDS (MAX 2)
16-24 BEVERAGE LINES: 10" CONDUIT LINE

SLAB ON GRADE CONDITION DETAIL

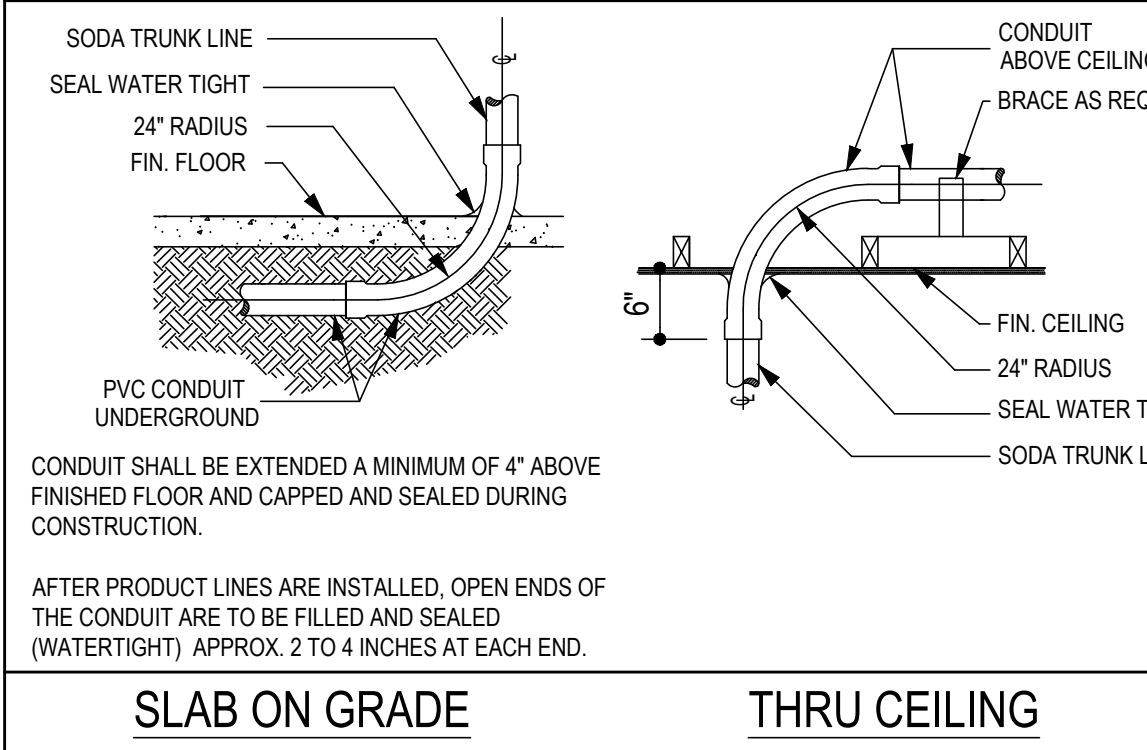

CONDUIT SHALL BE EXTENDED A MINIMUM OF 4" ABOVE FINISHED FLOOR AND CAPPED AND SEALED DURING CONSTRUCTION.

AFTER PRODUCT LINES ARE INSTALLED, OPEN ENDS OF THE CONDUIT ARE TO BE FILLED AND SEALED (WATERTIGHT) APPROX. 2 TO 4 INCHES AT EACH END.

SLAB ON GRADE

THRU CEILING

WALL BACKING NOTES AND OPTIONS

ALL HEIGHTS SPECIFIED IN THE OPTIONS SHOWN BELOW ARE ABOVE FINISH FLOOR.

LENGTHS OF WALL BACKING ARE NOMINAL. ALWAYS EXTEND TO THE NEXT STUD OVER EACH DIRECTION.


GENERAL CONTRACTOR SHALL REVIEW PLANS IN THEIR ENTIRETY SO AS TO DETERMINE OTHER WALL BACKING REQUIREMENTS NOT INDICATED ON CONDITIONS PLAN.

THIS DRAWING SHALL BE USED AS AN INSTRUMENT OF REFERENCE BY ALL OTHER TRADES AND CONTRACTORS. ALL TRADES SHALL VERIFY THE INFORMATION AS SHOWN ON THESE PLANS. FOR SPECIFIC CONNECTION INFORMATION, REFER TO THE ARCHITECT AND/OR CONTRACTOR'S DRAWINGS.

DIMENSIONS AND REQUIREMENTS FOR ALL EXISTING EQUIPMENT PROVIDED BY OTHERS MUST BE VERIFIED.

ALL NATIONAL, STATE AND LOCAL CODES SHALL APPLY.

GENERAL CONTRACTOR TO PROVIDE 3/4" PLYWOOD WALL BACKING ON WALLS SPECIFIED AS SHOWN ON THE OPTIONS SHOWN BELOW.

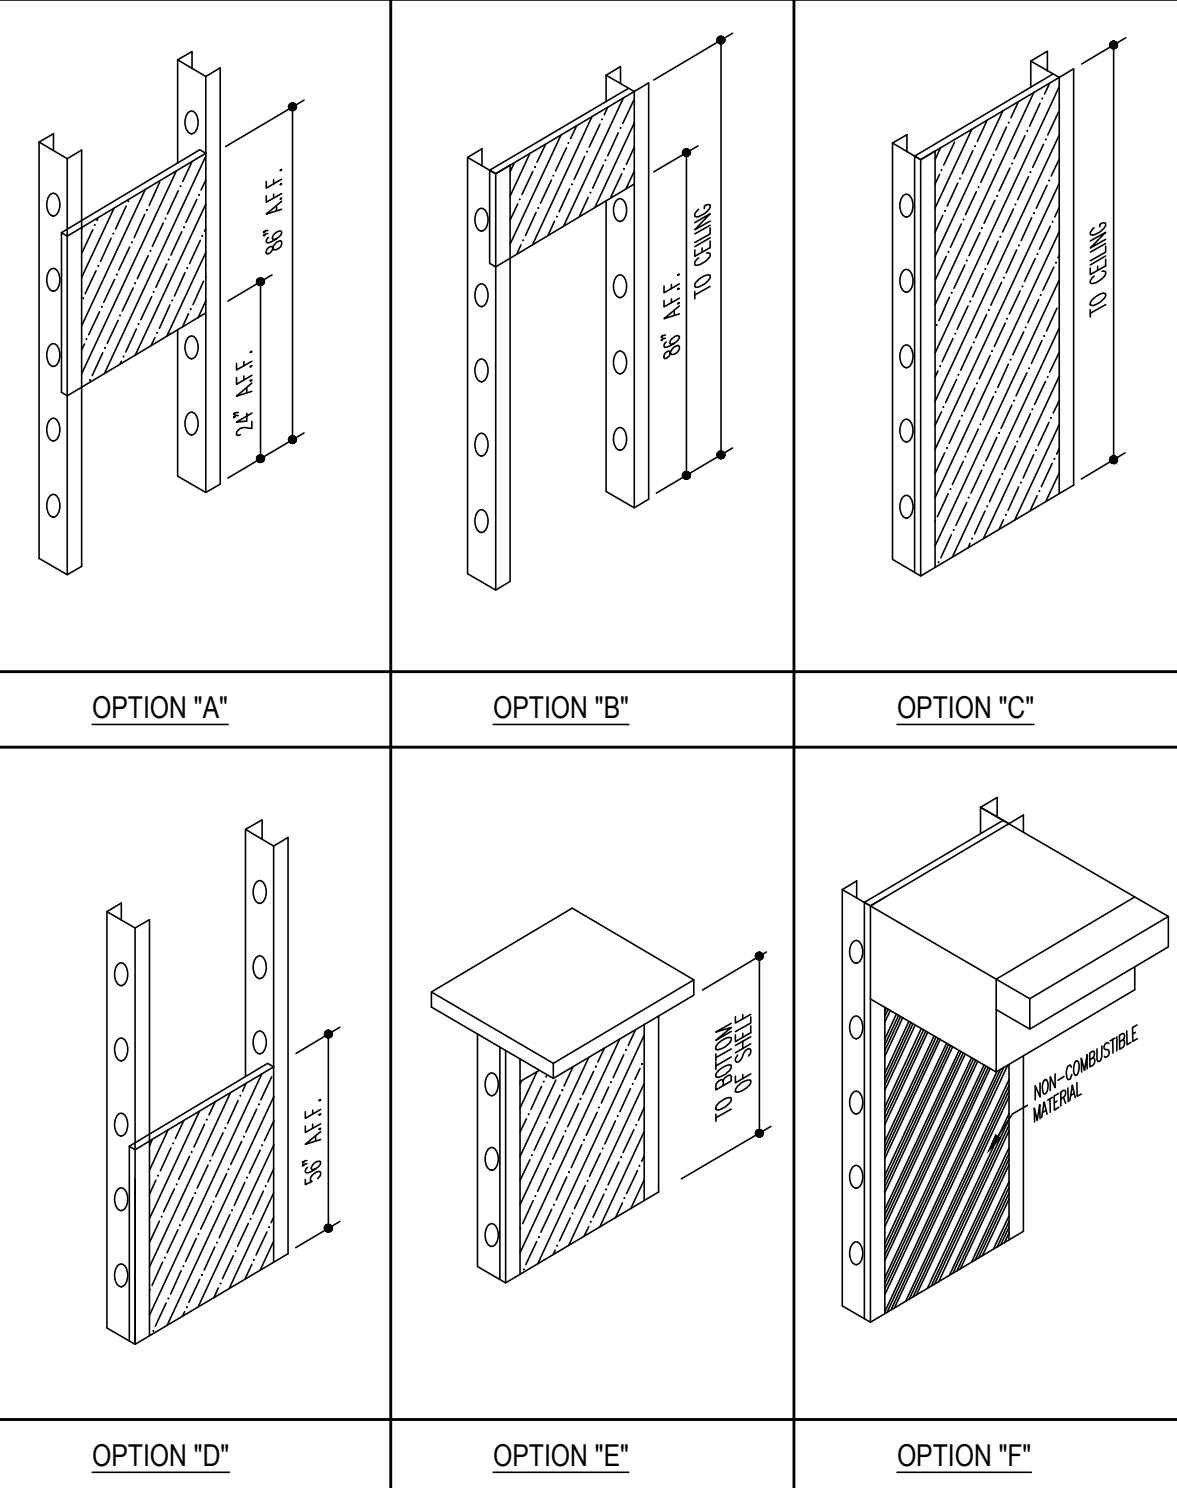

- NOT FOR CONSTRUCTION -

THIS DRAWING IS AN INSTRUMENT OF SERVICE ONLY FOR THE LICENSED ARCHITECT AND/OR ENGINEER ON THIS PROJECT.

PURSUANT TO FLORIDA STATUTE 481.229 SECTIONS 8A, 8B AND 8C THESE DESIGNS, SPECIFICATIONS AND/OR LAYOUTS CANNOT BE USED FOR CONSTRUCTION AND/OR INSTALLATION OF EQUIPMENT UNLESS REVIEWED AND APPROVED BY A LICENSED ARCHITECT OR ENGINEER.

THESE DRAWINGS ARE PRELIMINARY AND CONCEPTUAL IN NATURE. THEY ARE PROVIDED FOR GENERAL INFORMATION PURPOSES ONLY. ANYONE MAKING USE OF THESE DRAWINGS DOES SO AT THEIR OWN RISK AND ASSUMES ALL LIABILITY FOR SUBSEQUENT USE.

FOODSERVICE SPECIAL CONDITIONS PLAN

DESIGN DEVELOPMENT
KITCHEN DESIGN
CBI-22158

PALM BEACH COUNTY, FLORIDA

Cheney Brothers
EQUIPMENT & DESIGN DIVISION
Palm Beach County, Florida, 33404
1-877-CBI-CHIEF (224-2433) www.cheneybrothers.com

THIS DRAWING, INTELLECTUAL PROPERTY, AND ALL FACSIMILES, REPRODUCTIONS, AND ANY OTHER INFORMATION, SHALL BE THE PROPERTY OF CHENEY BROTHERS, INC. AND SHALL REMAIN THE PROPERTY OF CHENEY BROTHERS, INC. UNLESS OTHERWISE SPECIFIED. NO PART OF THIS DRAWING SHALL BE REPRODUCED OR TRANSMITTED IN ANY FORM OR BY ANY MEANS, ELECTRONIC OR MECHANICAL, INCLUDING PHOTOCOPYING, RECORDING, OR BY ANY INFORMATION STORAGE AND RETRIEVAL SYSTEM, WITHOUT THE WRITTEN PERMISSION OF CHENEY BROTHERS, INC. ANY INFORMATION CONTAINED HEREIN IS FOR INFORMATIONAL PURPOSES ONLY AND IS NOT TO BE USED FOR ANY OTHER PURPOSE. CHENEY BROTHERS, INC. ASSUMES NO RESPONSIBILITY FOR ANY CHANGES REQUIRED BY THE USER OF THIS DRAWING. CHENEY BROTHERS, INC. IS NOT TO BE USED WITH ANY OTHER DRAWINGS RELEASED FOR THIS PROJECT.

DESIGN APPROVAL




APPROVED ☐ APPROVED AS NOTED ☐ RESUBMIT WITH REVISIONS

APPROVED BY: _____ DATE: _____

NO.	DESCRIPTION	DATE
1	DESIGN APPROVAL	08/06/2022
2	DESIGN APPROVAL	08/06/2022
SCALE: 1/4"=1'-0"

K1-4.0

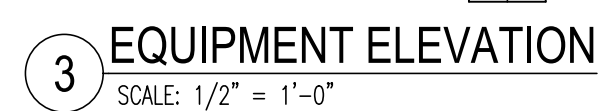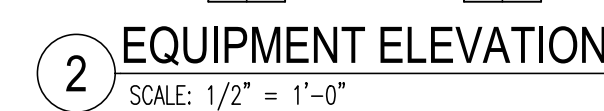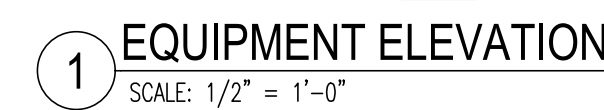

THIS DRAWING IS AN INSTRUMENT OF SERVICE ONLY FOR THE LICENSED ARCHITECT AND/OR ENGINEER ON THIS PROJECT.

PURSUANT TO FLORIDA STATUTE 481.229 SECTIONS BA, BB AND BC, THESE DESIGNS, SPECIFICATIONS AND/OR LAYOUTS CANNOT BE USED FOR CONSTRUCTION AND/OR INSTALLATION OF EQUIPMENT UNLESS REVIEWED AND APPROVED BY A LICENSED ARCHITECT OR ENGINEER.

THESE DRAWINGS ARE PRELIMINARY AND CONCEPTUAL IN NATURE THEY ARE PROVIDED FOR GENERAL INFORMATION PURPOSES ONLY. ANYONE MAKING USE OF THESE DRAWINGS DOES SO AT THEIR OWN RISK AND ASSUMES ALL LIABILITY

CBI-22158
PALM BEACH COUNTY, FLORIDA





SCALE: 1/4"=1'-0"

DESIGN APPROVAL

REVISIONS AND MODIFICATIONS:		
NO.	DESCRIPTION	DATE:
△	DESIGN ADJUSTMENTS	09/14/22
△	DESIGN ADJUSTMENTS; MEP & ELEWTRONICS RELEASE	10/17/22
△	ADJUSTMENTS PER NEW ARCHITECTURAL BASE;	10/19/22
	ADDED ITEM 710.1	
△	GENERAL REMISSIONS; REVISED COOKING SUITE 700	11/23/22

THIS DRAWING, WITH CERTAIN PROPERTY AND INTELLECTUAL RIGHTS, IS BEING TRANSMITTED WITH THIS DOCUMENT LEGALLY OWNED BY CHENEY BROTHERS, INC. THE RECIPIENT OF THIS DRAWING IS HEREBY NOTIFIED THAT ANY READING, REPRODUCTION, COPIING, OR ANY OTHER USE OF THIS DRAWING WITHOUT THE WRITTEN CONSENT OF CHENEY BROTHERS, INC. IS STRICTLY PROHIBITED. NEITHER THIS DRAWING NOR THE INFORMATION THAT IT CONTAINS MAY BE REPRODUCED OR DISCLOSED IN ANY MANNER WITHOUT THE WRITTEN CONSENT OF CHENEY BROTHERS, INC. NO PART OF THIS DRAWING OR THE INFORMATION THEREIN MAY BE USED IN ANY MANNER, IN WHOLE OR IN PART, WITHOUT THE WRITTEN CONSENT OF CHENEY BROTHERS, INC. TO ANY COST OR DAMAGE FOR ANY ERRORS OR OMISSIONS OF ALL MATERIAL ENCLOSED IS THE PROPERTY OF CHENEY BROTHERS, INC. NO LIABILITY FOR ANY DAMAGES OR LOSSES, INCLUDING REASONABLE ATTORNEY'S FEES, SHALL BE INCURRED BY CHENEY BROTHERS, INC. FOR ANY REASON. CHENEY BROTHERS, INC. ASSUMES NO RESPONSIBILITY FOR ANY CHANGES REQUIRED BY THE USER OF THIS DRAWING. CHENEY BROTHERS, INC. DOES NOT BE RESPONSIBLE FOR ANY CHANGES OR MODIFICATIONS TO ANY DRAWING OR INFORMATION THAT MAY BE USED WITH ANY OTHERS OR ANY OTHERS ISSUED FOR THIS PROJECT.



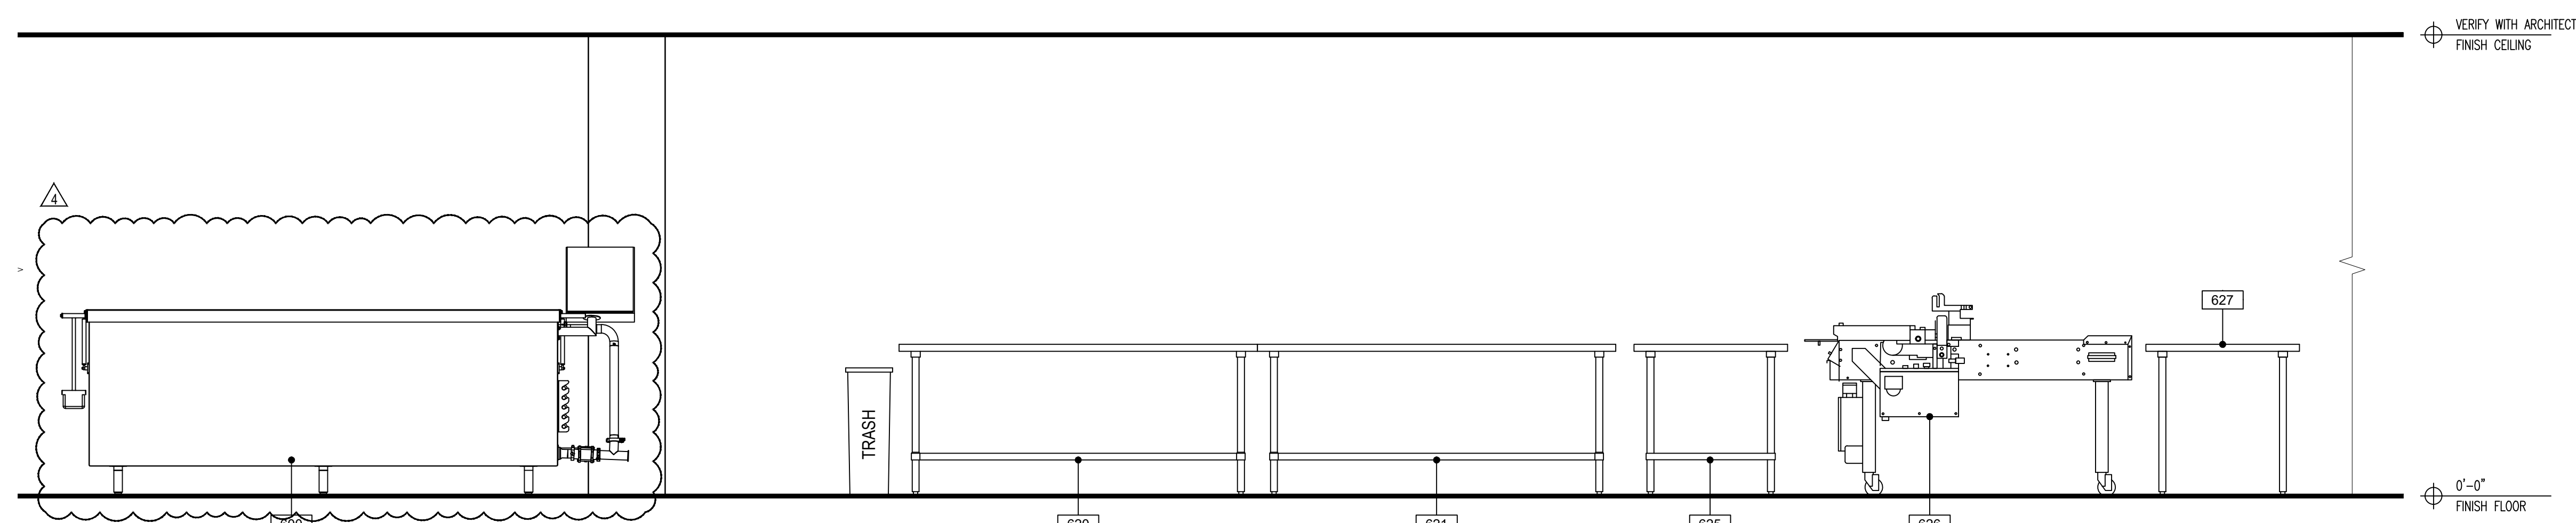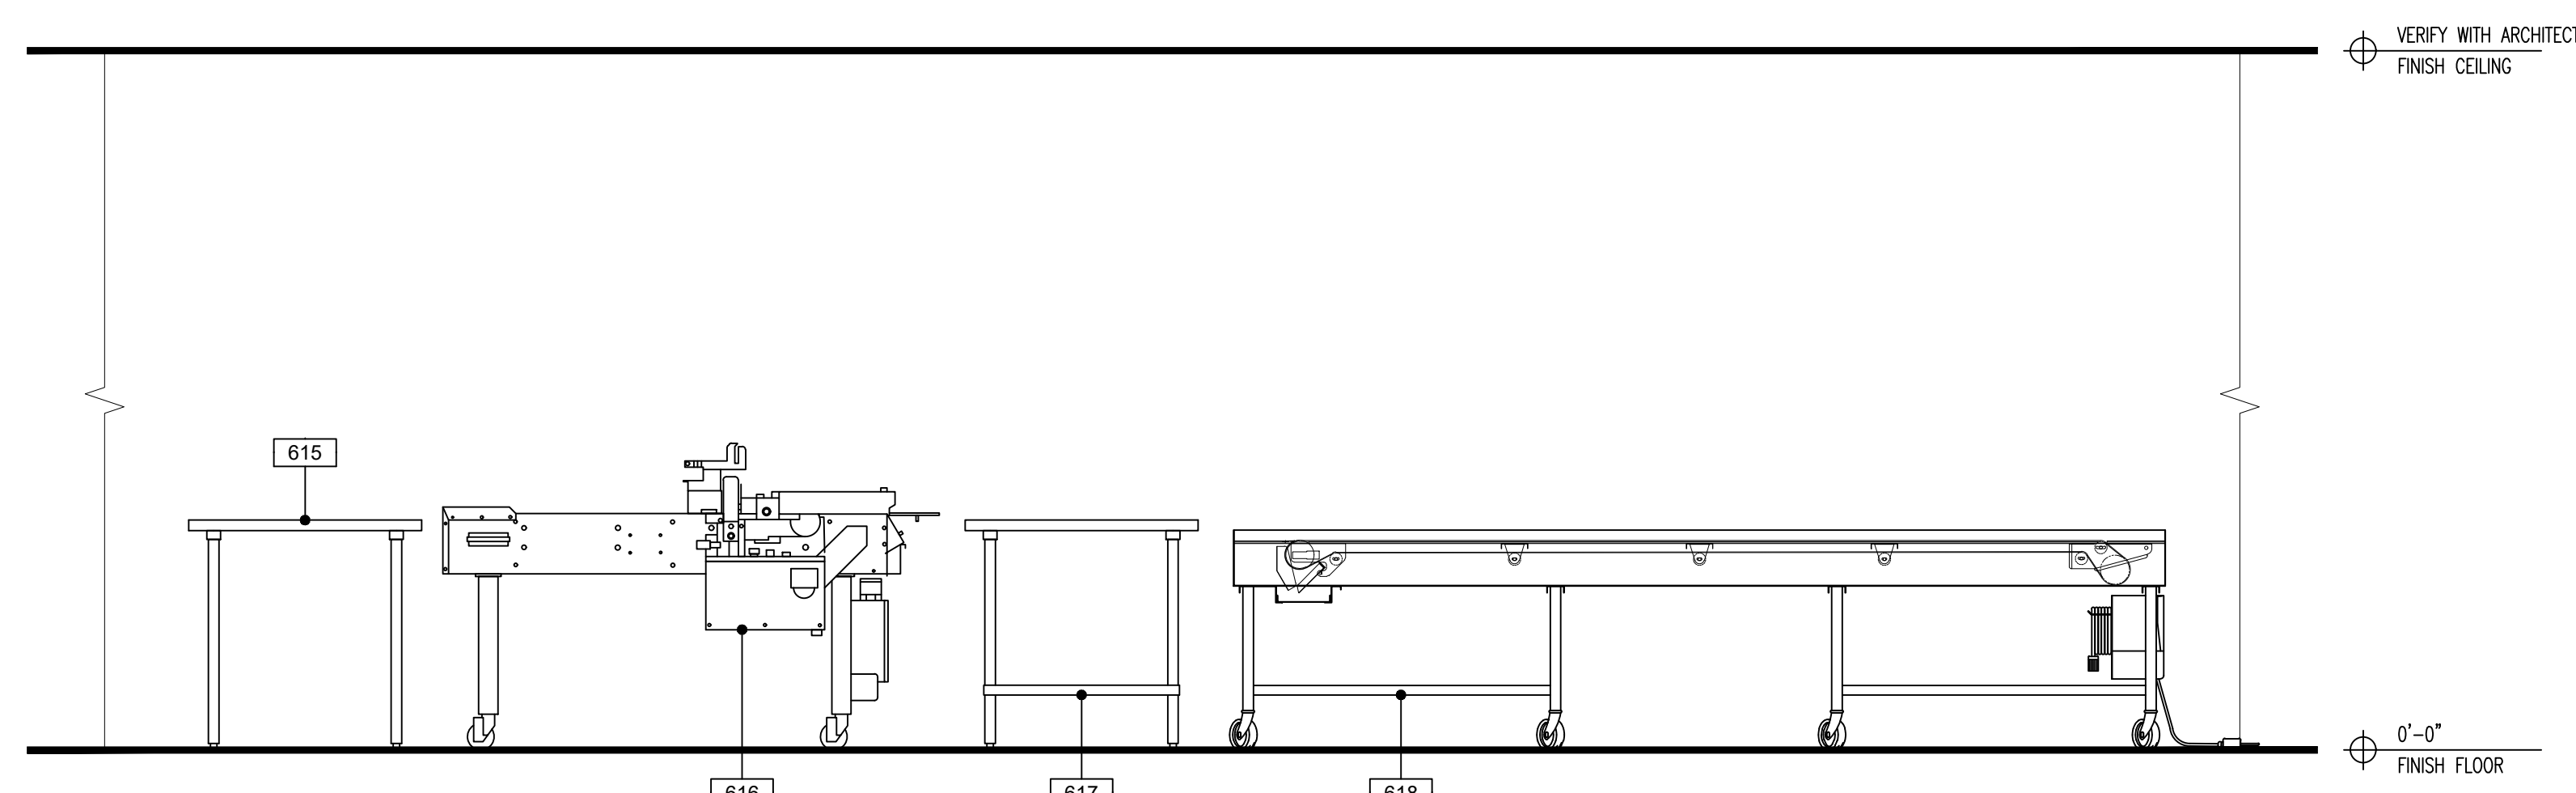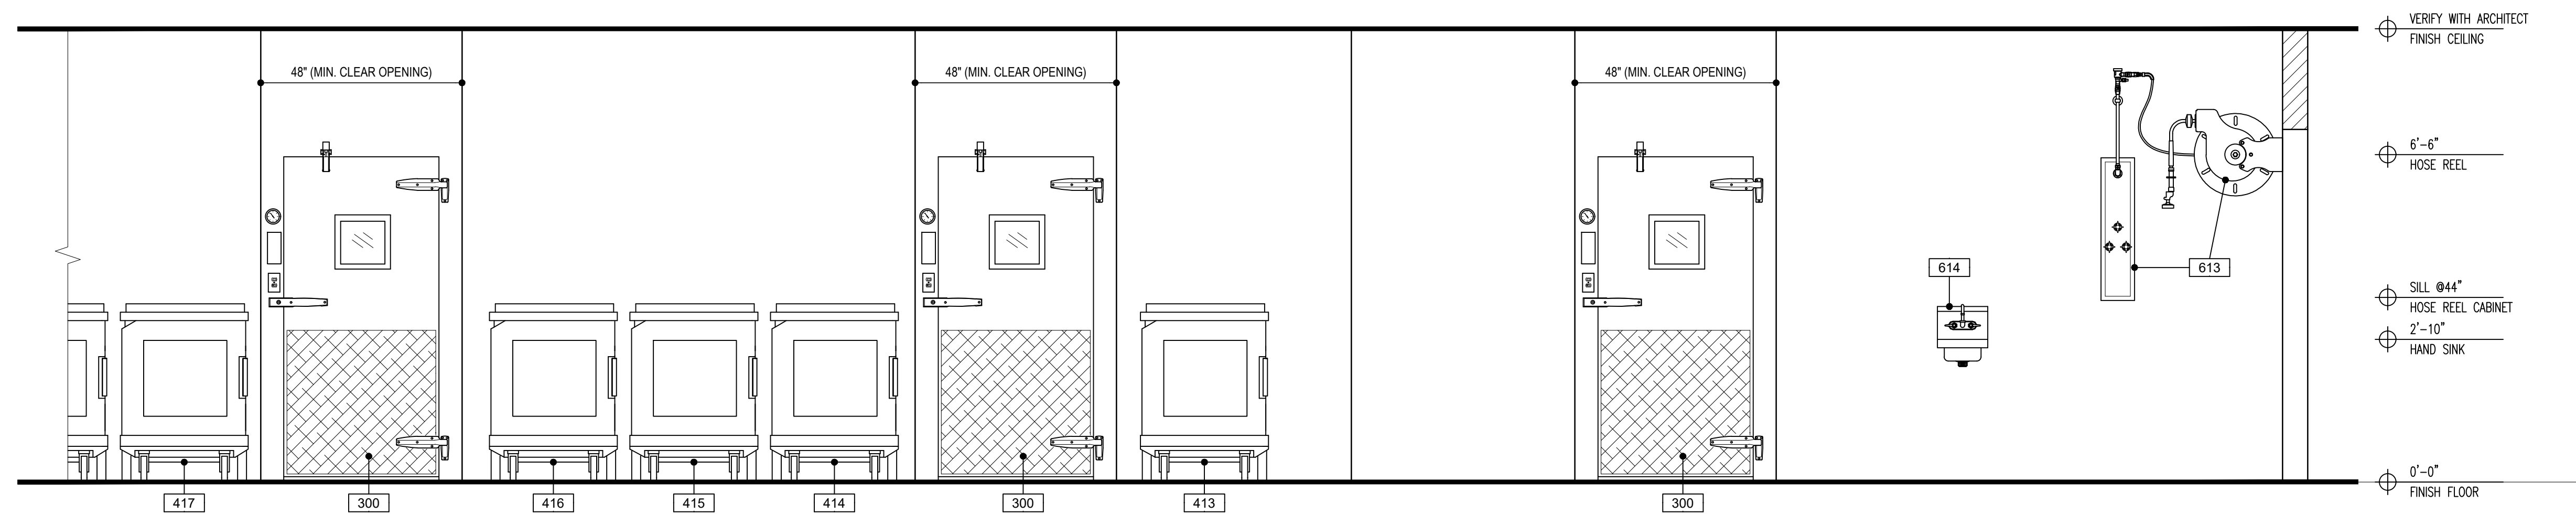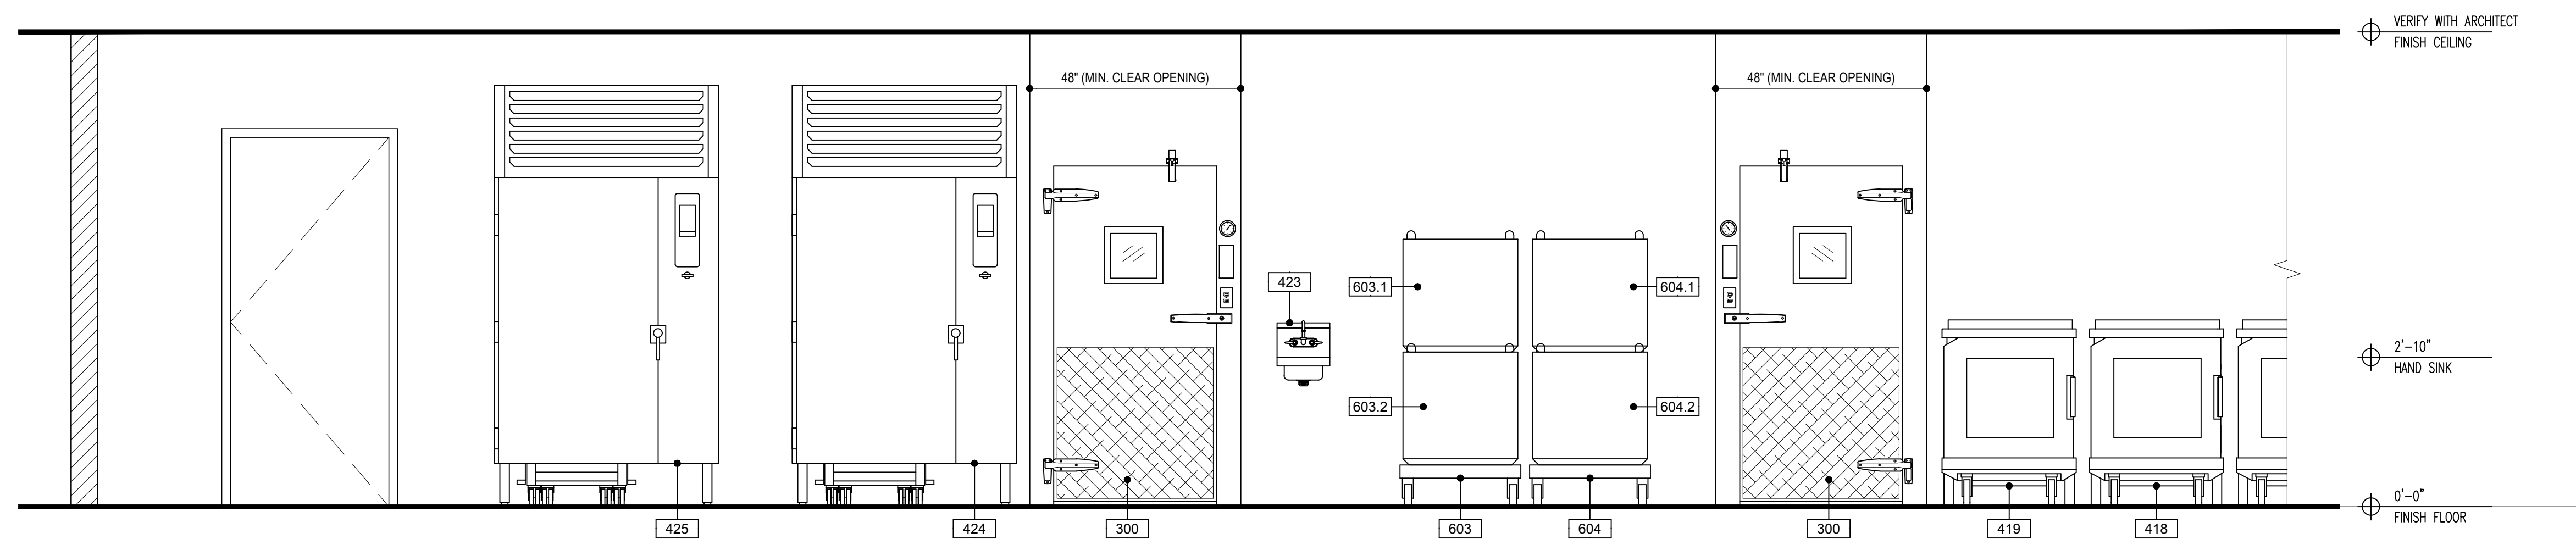

- NOT FOR CONSTRUCTION -

THIS DRAWING IS AN INSTRUMENT OF SERVICE ONLY FOR THE LICENSED ARCHITECT AND/OR ENGINEER ON THIS PROJECT.

PURSUIT TO FLORIDA STATUTE 481.229 SECTIONS BA, BB AND BC THESE DESIGNS, SPECIFICATIONS AND/OR LOCATIONS CANNOT BE USED FOR CONSTRUCTION AND/OR INSTALLATION OF EQUIPMENT UNLESS REVIEWED AND APPROVED BY A LICENSED ARCHITECT OR ENGINEER.

THESE DRAWINGS ARE PRELIMINARY AND CONCEPTUAL. IN NATURE THEY ARE PROVIDED FOR GENERAL INFORMATION PURPOSES ONLY. ANYONE MAKING USE OF THESE DRAWINGS DOES SO AT THEIR OWN RISK AND ASSUMES ALL LIABILITY FOR SUBSEQUENT USE.

FOODSERVICE ELEVATIONS

DESIGN DEVELOPMENT
KITCHEN DESIGN
CBI-22158
PALM BEACH COUNTY, FLORIDA

Cheney

C-B-I
Since 1955

Brothers

EQUIPMENT & DESIGN DIVISION

2061 Martin Luther King Jr. Blvd.
Riviera Beach, Florida 33404


—877—CBI-CHEF (224-2433)

www.cheneybrothers.com


DESIGN APPROVAL

REVISIONS AND MODIFICATIONS:		
NO.	DESCRIPTION	DATE
1	DESIGN ADJUSTMENTS	09/14/72
2	DESIGN ADJUSTMENTS, MEP & ELEVATIONS RELEASE	10/17/72
3	ADJUSTMENTS PER NEW ARCHITECTURAL BASE:	09/19/72
	ADDED ITEM 70.1	
4	GENERAL REVISIONS, PRESSED COATING SUITE ITEM 70.2/72/72	11/23/72


SCALE: 1/4"=1'-0"

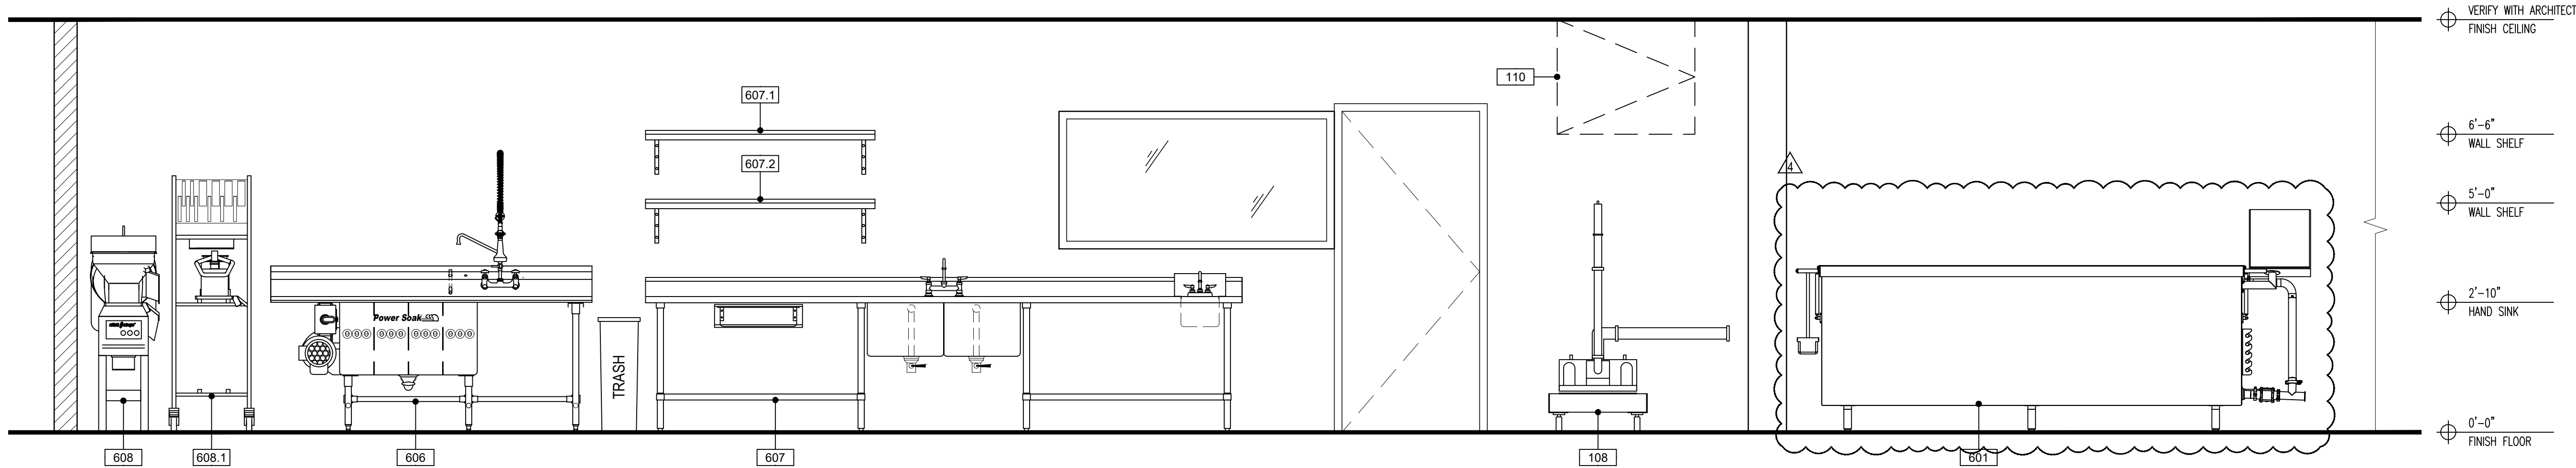


10 EQUIPMENT ELEVATION
SCALE: 1/2" = 1'-0"

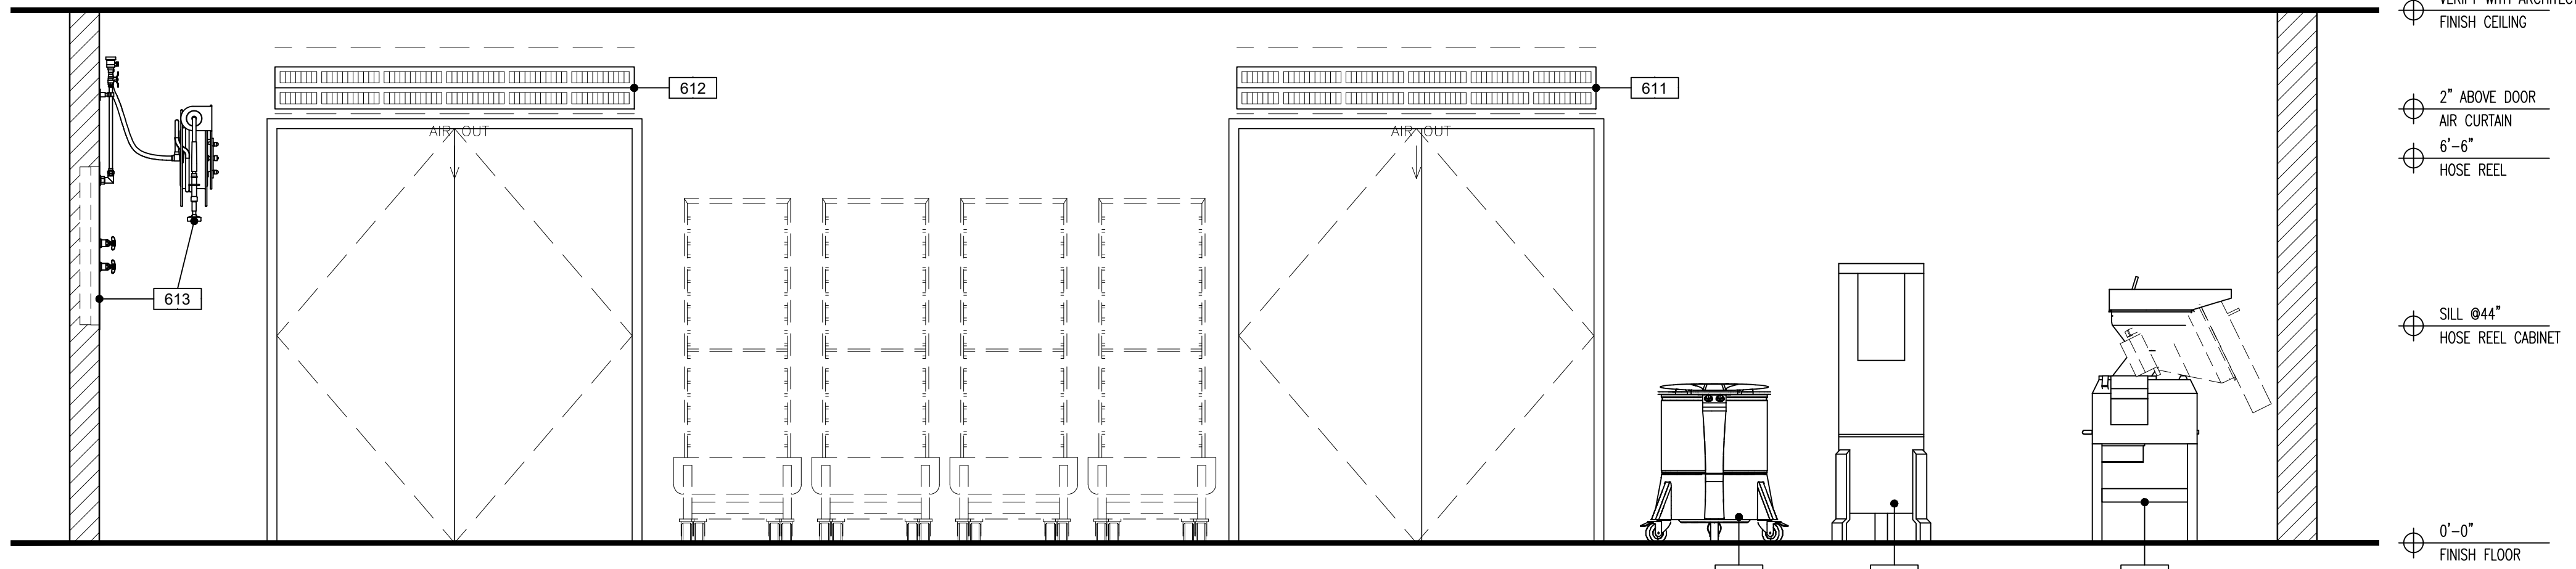


11 EQUIPMENT ELEVATION
SCALE: 1/2" = 1'-0"

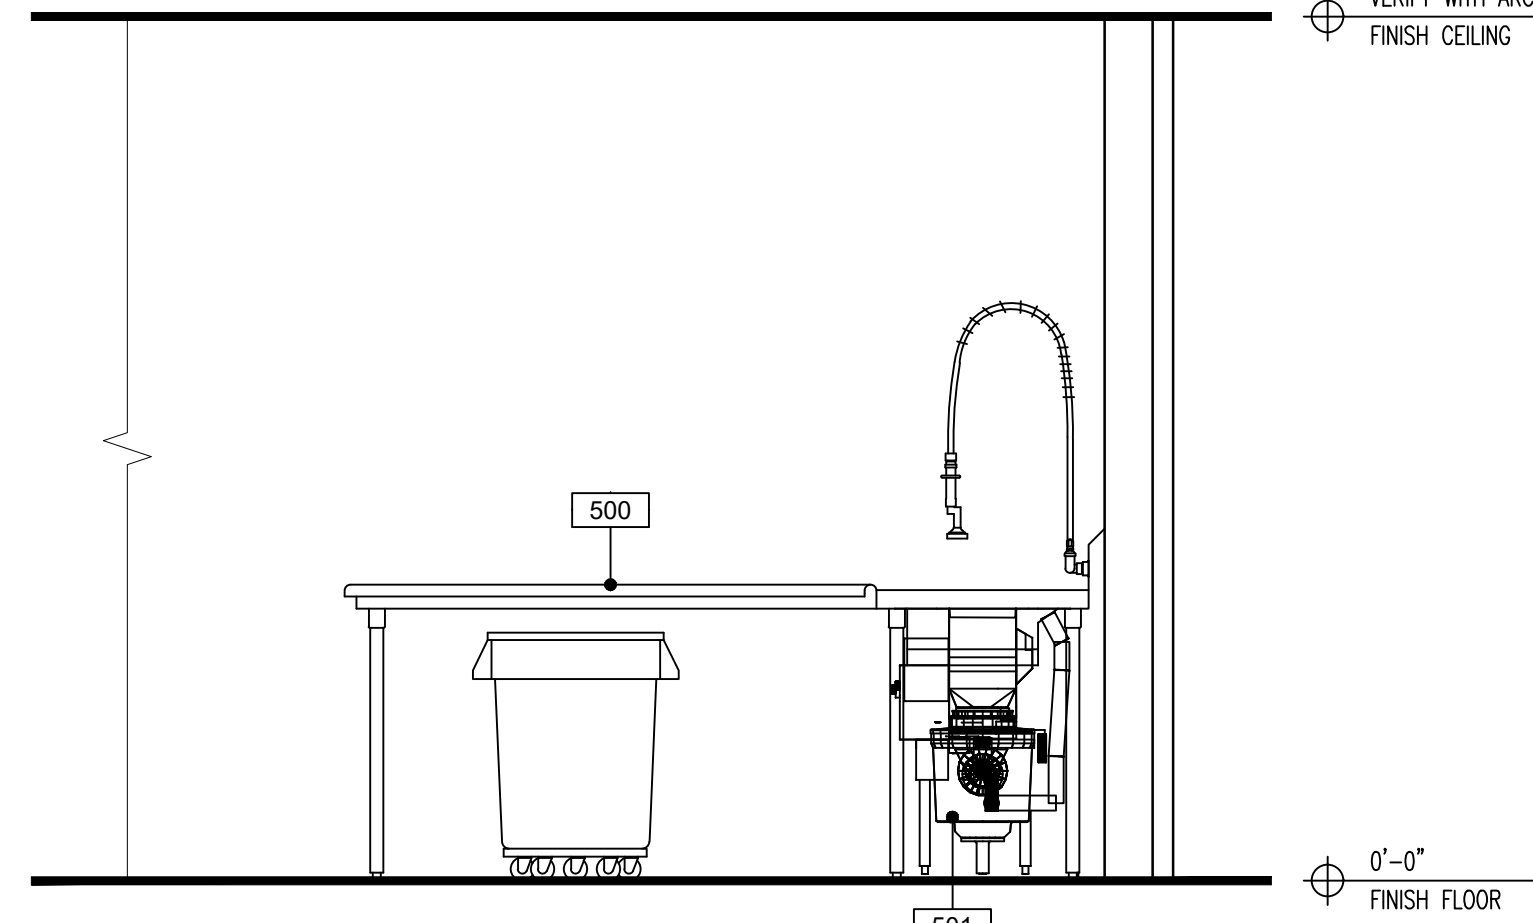


12 EQUIPMENT ELEVATION
SCALE: 1/2" = 1'-0"

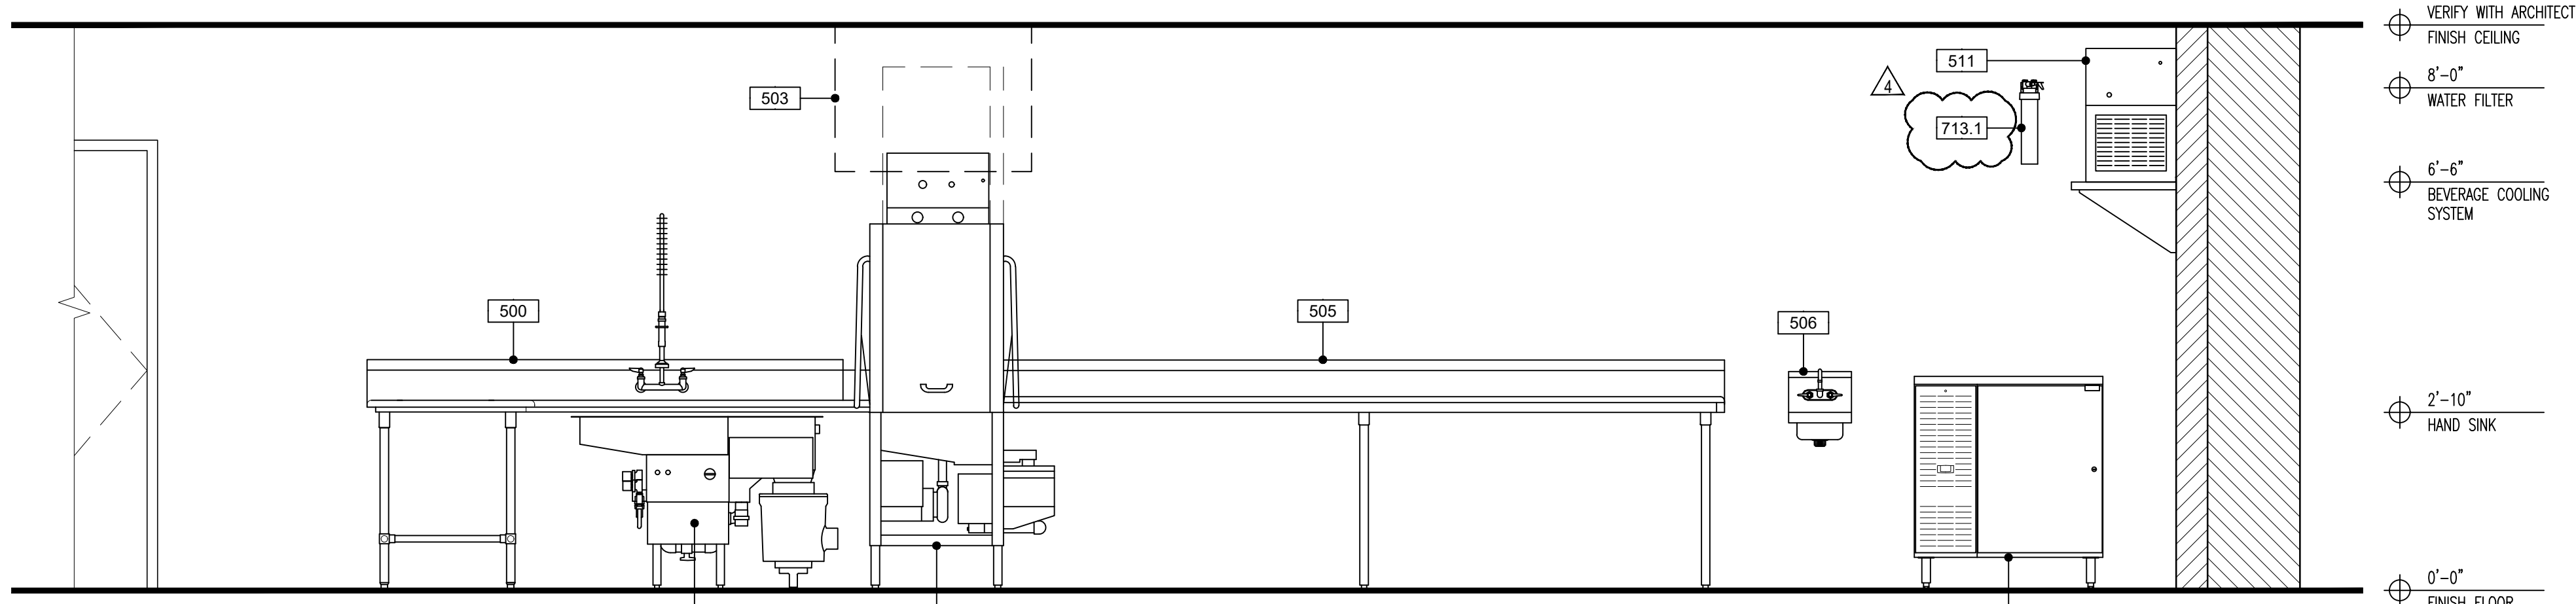

13 EQUIPMENT ELEVATION
SCALE: 1/2" = 1'-0"

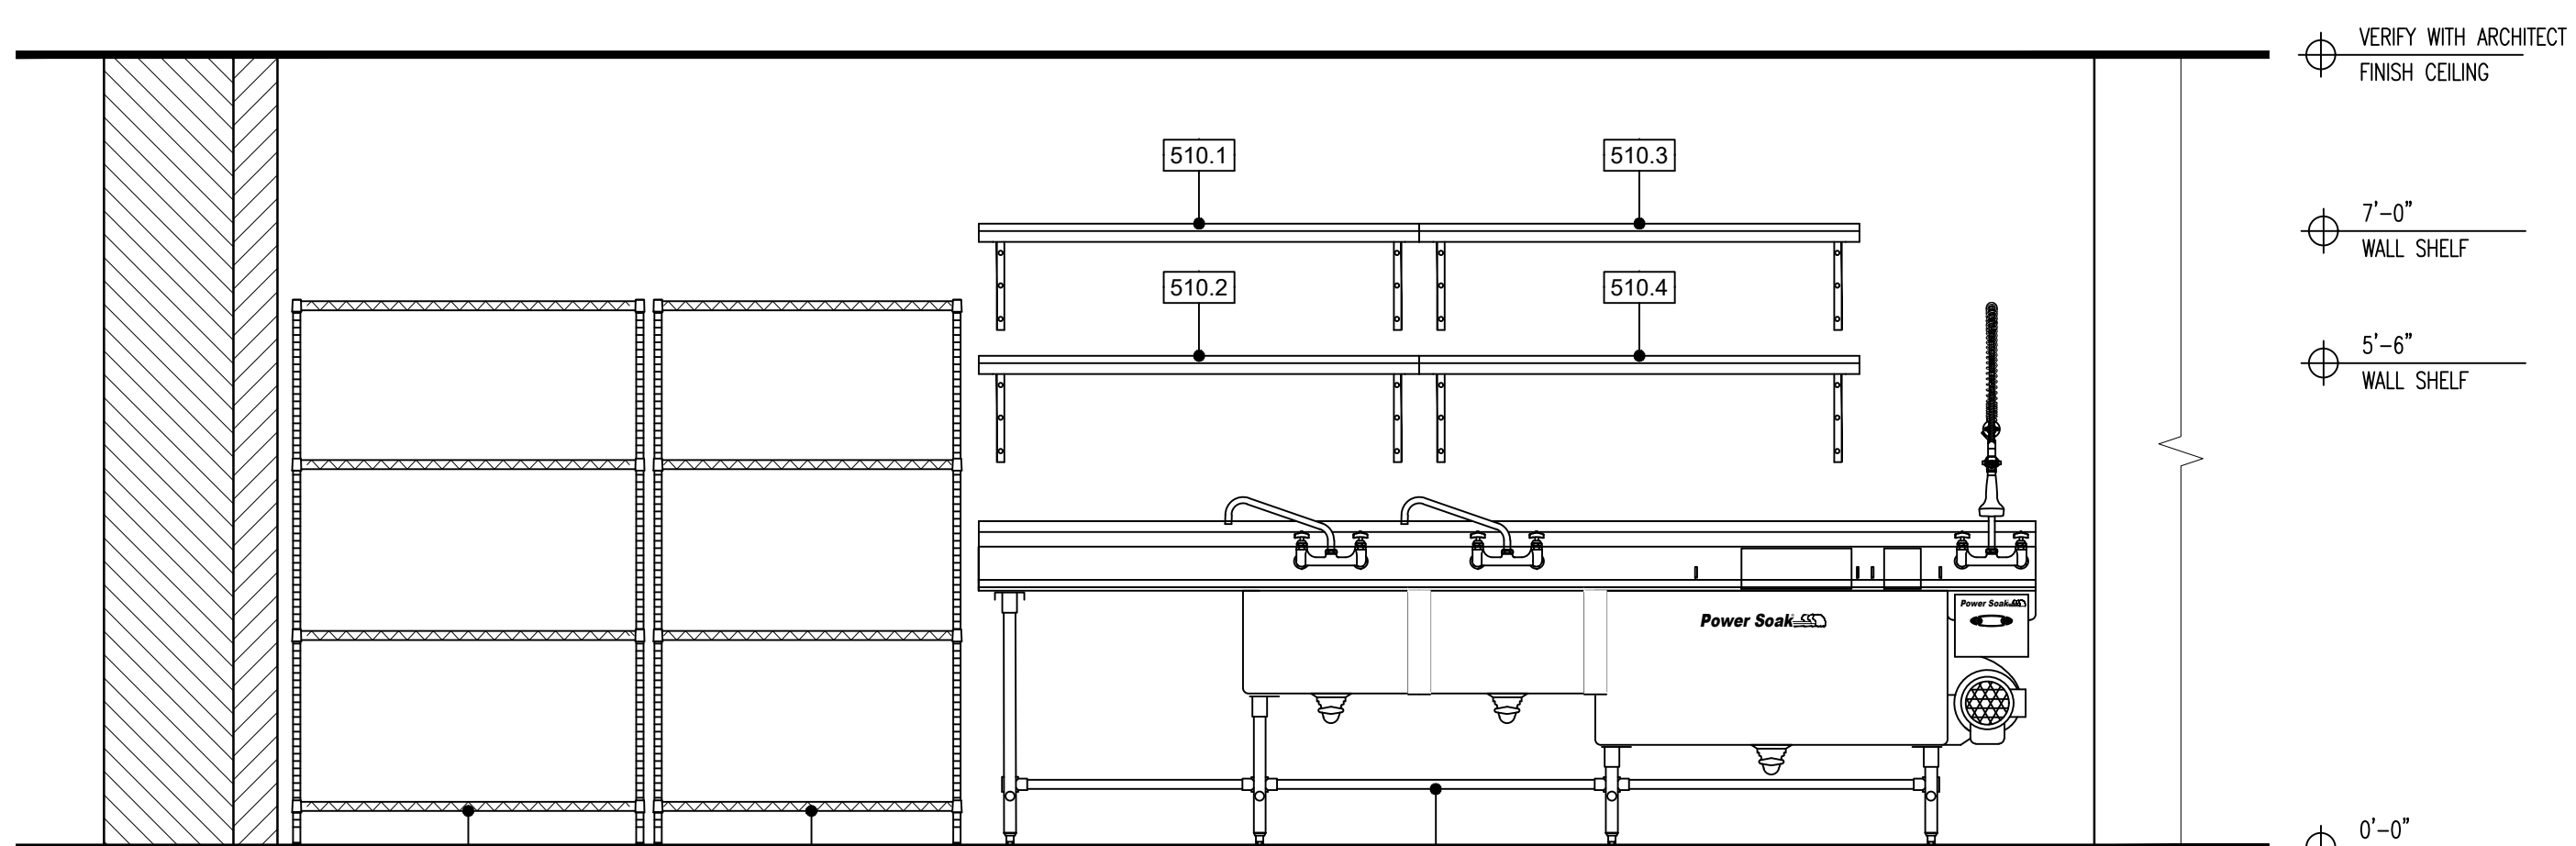

14 EQUIPMENT ELEVATION
SCALE: 1/2" = 1'-0"

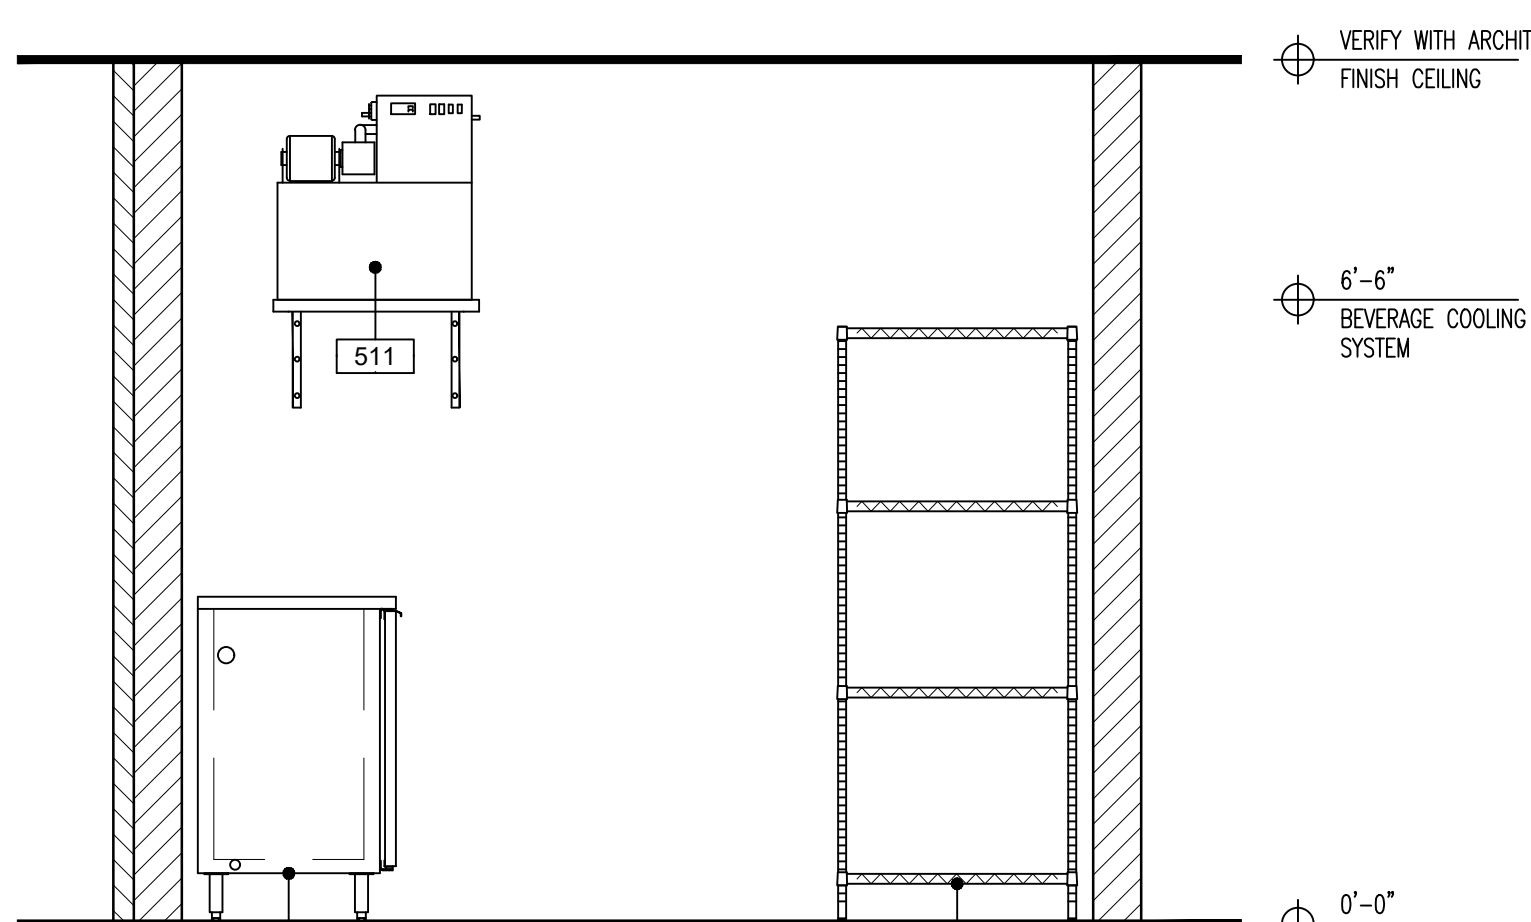

15 EQUIPMENT ELEVATION
SCALE: 1/2" = 1'-0"

- NOT FOR CONSTRUCTION -

THIS DRAWING IS AN INSTRUMENT OF SERVICE ONLY FOR THE LICENSED ARCHITECT AND/OR ENGINEER ON THIS PROJECT.

PURSUANT TO FLORIDA STATUTE 481.229 SECTIONS BA, BB AND BC THESE DESIGNS, SPECIFICATIONS AND/OR LAYOUTS CANNOT BE USED FOR CONSTRUCTION AND/OR INSTALLATION OF EQUIPMENT UNLESS REVIEWED AND APPROVED BY A LICENSED ARCHITECT OR ENGINEER.

THESE DRAWINGS ARE PRELIMINARY AND CONCEPTUAL IN NATURE. THEY ARE PROVIDED FOR GENERAL INFORMATION PURPOSES ONLY. ANYONE MAKING USE OF THESE DRAWINGS DOES SO AT THEIR OWN RISK AND ASSUMES ALL LIABILITY FOR SUBSEQUENT USE.

FOODSERVICE ELEVATIONS

DESIGN DEVELOPMENT
KITCHEN DESIGN
CBI-22158
PALM BEACH COUNTY, FLORIDA


Cheney Brothers
EQUIPMENT & DESIGN DIVISION
2801 N. U.S. 1
P.O. Box 13404
Fort Lauderdale, FL 33324
1-877-CBI-CHIEF (221-2433) www.cheneybrothers.com

DESIGN APPROVAL
☐ APPROVED ☐ APPROVED AS NOTED ☐ RESUBMIT IN NEW DESIGN


THIS DRAWING, ITS CONTENTS, AND ALL ATTACHMENTS ARE THE PROPERTY OF CHENEY BROTHERS, INC. AND ARE NOT TO BE REPRODUCED OR DISCLOSED IN ANY MANNER WITHOUT THE WRITTEN CONSENT OF CHENEY BROTHERS, INC. ANY REPRODUCTION OR DISCLOSURE OF THIS DRAWING OR ITS CONTENTS TO ANY OTHER PARTY WITHOUT THE WRITTEN CONSENT OF CHENEY BROTHERS, INC. IS STRICTLY PROHIBITED. CHENEY BROTHERS, INC. ASSUMES NO LIABILITY FOR ANY ERRORS OR OMISSIONS IN THIS DRAWING OR ITS CONTENTS. CHENEY BROTHERS, INC. IS NOT A DESIGN PROFESSIONAL AND DOES NOT PROVIDE DESIGN SERVICES. CHENEY BROTHERS, INC. IS A TRADING COMPANY AND DOES NOT PROVIDE ANY OTHER SERVICES.

NO.	DESCRIPTION	DATE
1	DESIGN APPROVAL	10/17/22
2	DESIGN APPROVAL	10/17/22
3	DESIGN APPROVAL	10/17/22
SCALE: 1/4"=1'-0"

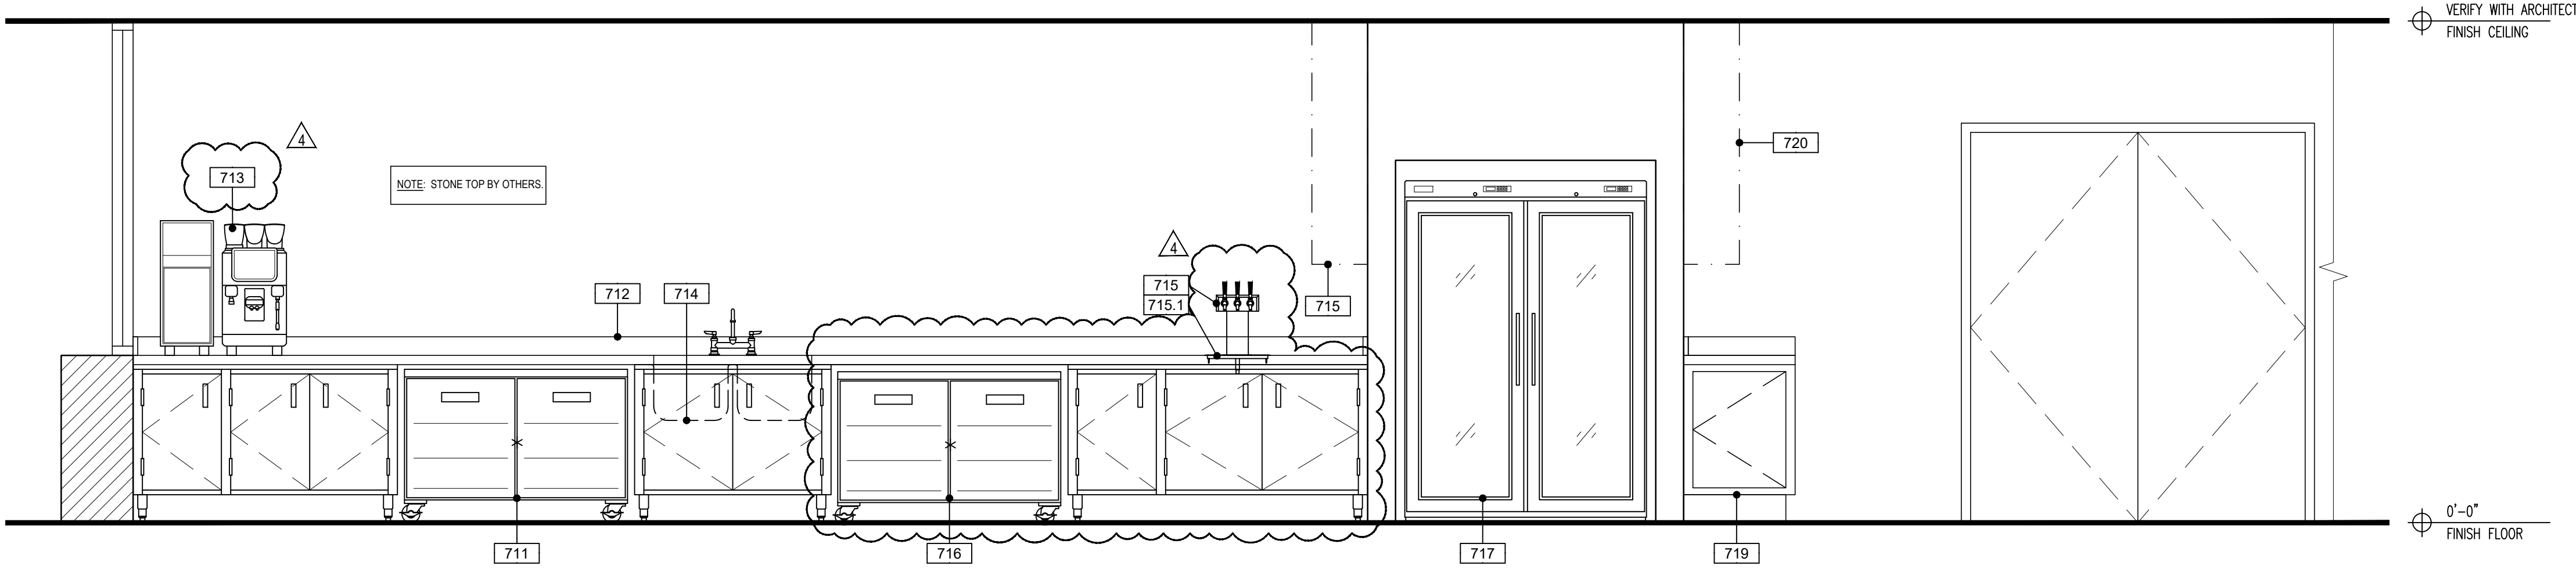

16 EQUIPMENT ELEVATION
SCALE: 1/2" = 1'-0"

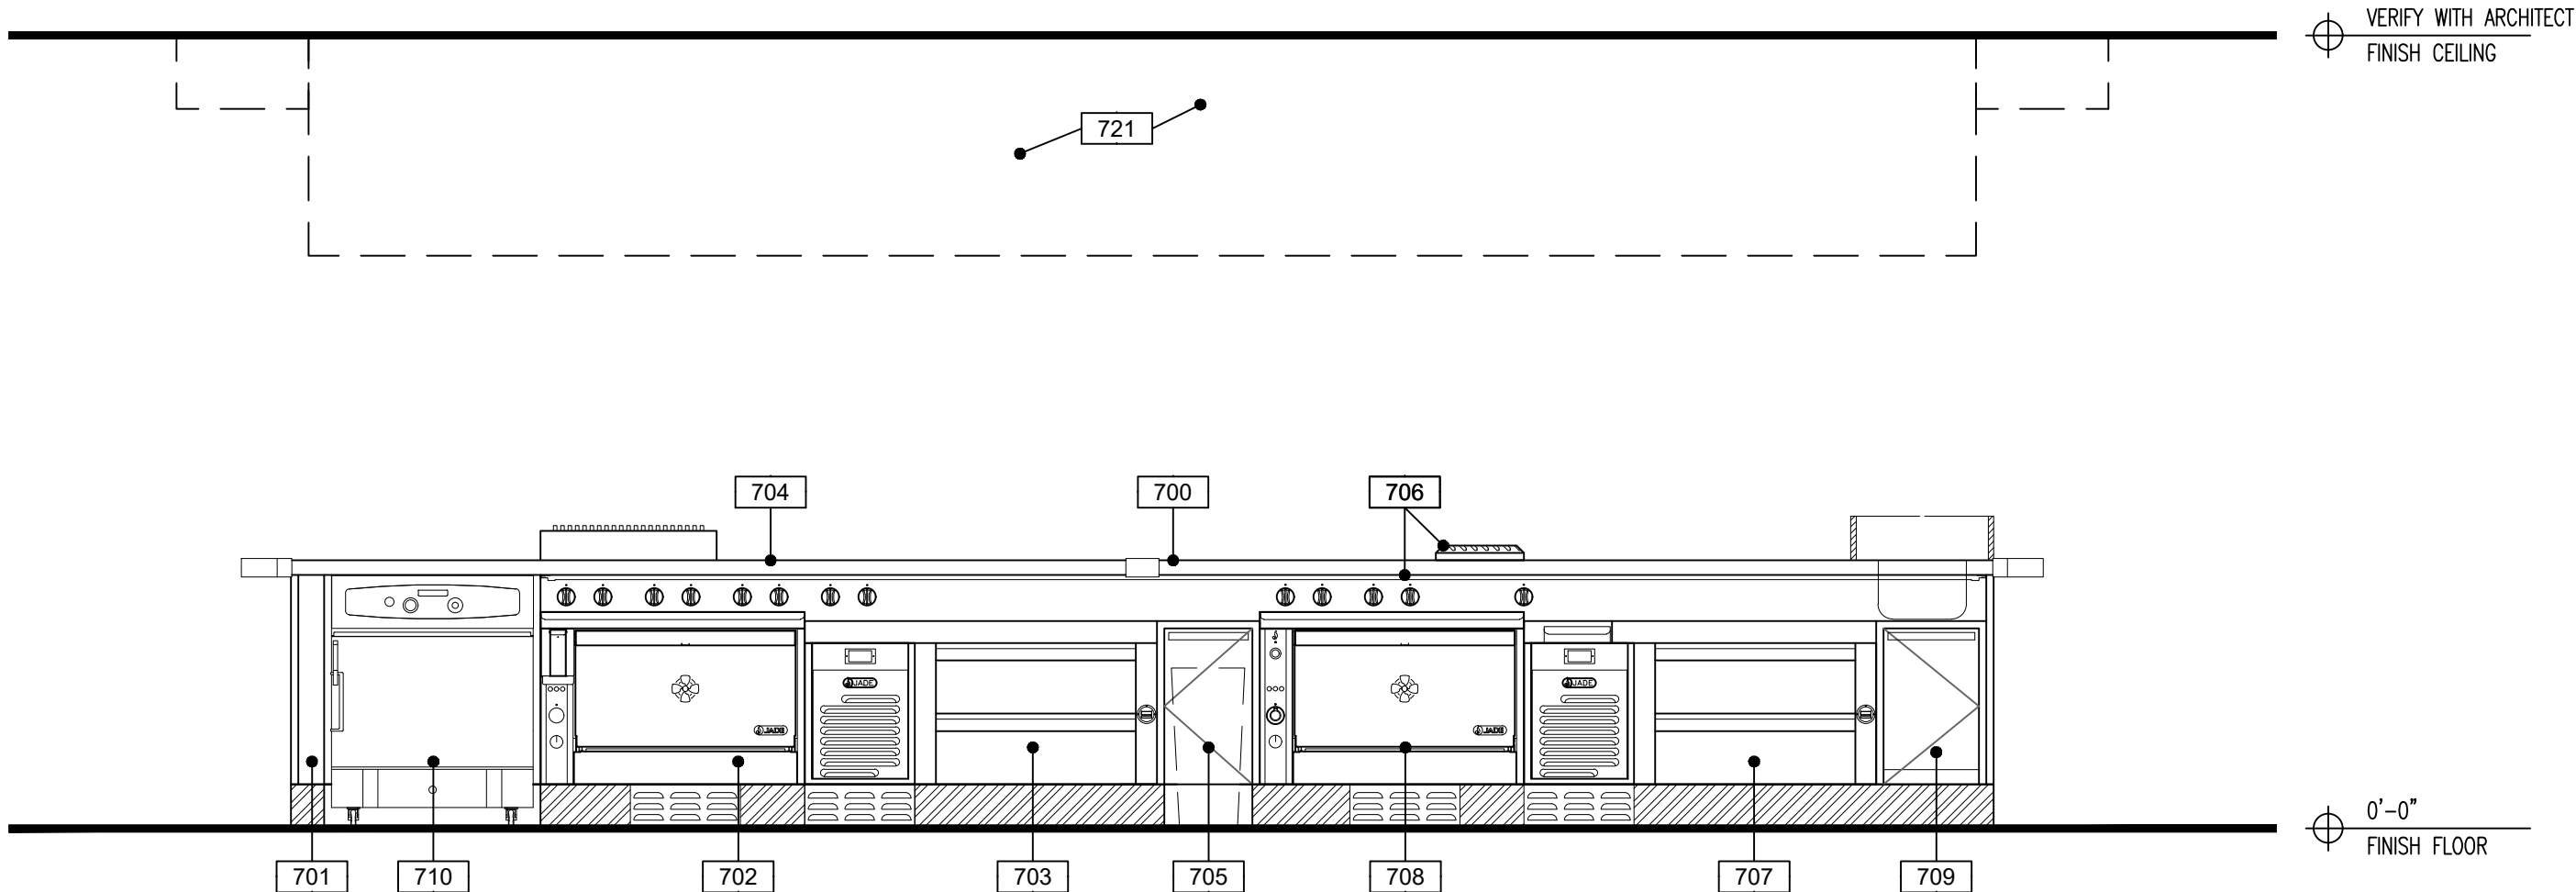

17 EQUIPMENT ELEVATION
SCALE: 1/2" = 1'-0"

- NOT FOR CONSTRUCTION -

THIS DRAWING IS AN INSTRUMENT OF SERVICE ONLY FOR THE LICENSED ARCHITECT AND/OR ENGINEER ON THIS PROJECT.

PURSUANT TO FLORIDA STATUTE 481.229 SECTIONS BA, BB AND BC THESE DESIGNS, SPECIFICATIONS AND/OR LAYOUTS CANNOT BE USED FOR CONSTRUCTION AND/OR INSTALLATION OF EQUIPMENT UNLESS REVIEWED AND APPROVED BY A LICENSED ARCHITECT OR ENGINEER.

THESE DRAWINGS ARE PRELIMINARY AND CONCEPTUAL IN NATURE THEY ARE PROVIDED FOR GENERAL INFORMATION PURPOSES ONLY. ANYONE MAKING USE OF THESE DRAWINGS DOES SO AT THEIR OWN RISK AND ASSUMES ALL LIABILITY FOR SUBSEQUENT USE.

FOODSERVICE ELEVATIONS

DESIGN DEVELOPMENT
KITCHEN DESIGN
CBI-22158
PALM BEACH COUNTY, FLORIDA

Cheney Brothers
EQUIPMENT & DESIGN DIVISION
2061 N. U.S. 1
Beverly Beach, Florida, 33404
1-877-CBI-CHIEF (221-2433) www.cheneybrothers.com

DESIGN APPROVAL

☐ APPROVED ☐ APPROVED AS NOTED ☐ RESUBMIT IN NEW DESIGN
APPROVED BY: _____ DATE: _____
TITLE: _____

THIS DRAWING, INTELLECTUAL PROPERTY, AND ALL ATTACHMENTS ARE THE SOLE PROPERTY OF CHENEY BROTHERS, INC. NO PART OF THIS DRAWING OR ANY INFORMATION CONTAINED HEREIN IS TO BE REPRODUCED, COPIED, OR OTHERWISE TRANSMITTED IN ANY FORM OR BY ANY MEANS, ELECTRONIC OR MECHANICAL, INCLUDING PHOTOCOPYING, RECORDING, OR BY ANY INFORMATION STORAGE AND RETRIEVAL SYSTEM, WITHOUT THE WRITTEN PERMISSION OF CHENEY BROTHERS, INC. FURTHERMORE, ANY DISSEMINATION IN WHOLE OR IN PART OF THE CONTENTS OF THIS DRAWING TO ANY OTHER PARTY WITHOUT THE WRITTEN PERMISSION OF CHENEY BROTHERS, INC. IS STRICTLY PROHIBITED. CHENEY BROTHERS, INC. DOES NOT GIVE OR GRANT ANY RIGHTS OR PERMISSIONS TO USE ANY PART OF THIS DRAWING FOR ANY OTHER PROJECT OR FOR ANY OTHER PURPOSE.

NO.	DESCRIPTION	DATE
1	DESIGN APPROVAL	09/17/22
2	DESIGN APPROVAL	09/17/22
3	DESIGN APPROVAL	09/17/22
SCALE: 1/4"=1'-0"

K1-5.3